


T.10-11S. R.8W.W.M.

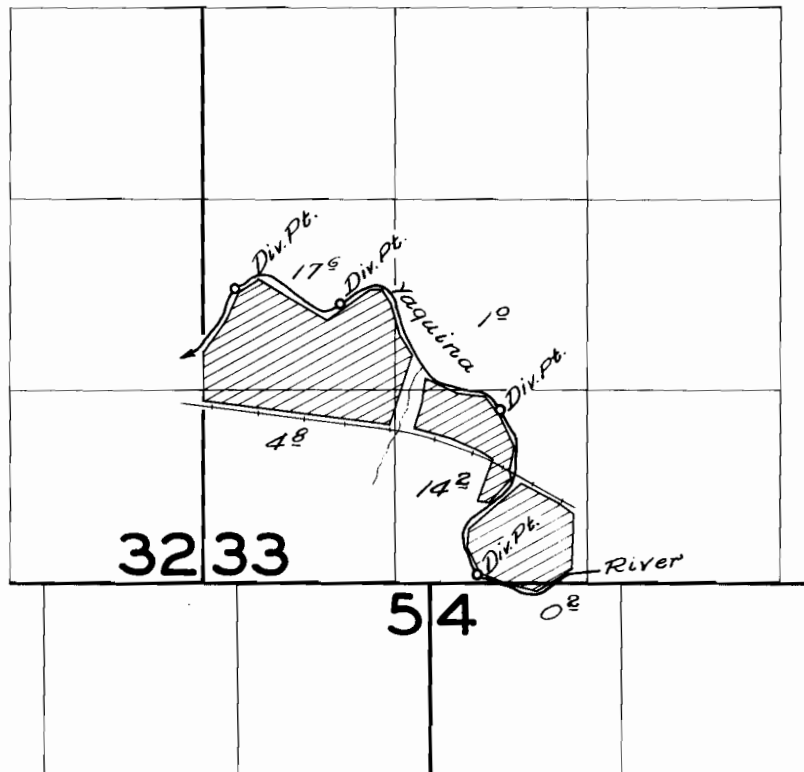

FINAL PROOF SURVEY
UNDER

Application No. 27341... Permit No. 21529...
IN NAME OF

Norman C. Edwards

Surveyed April 23 1959, by *C. O. Burtels*