


T. 20 S. R. 5 W. W.M.

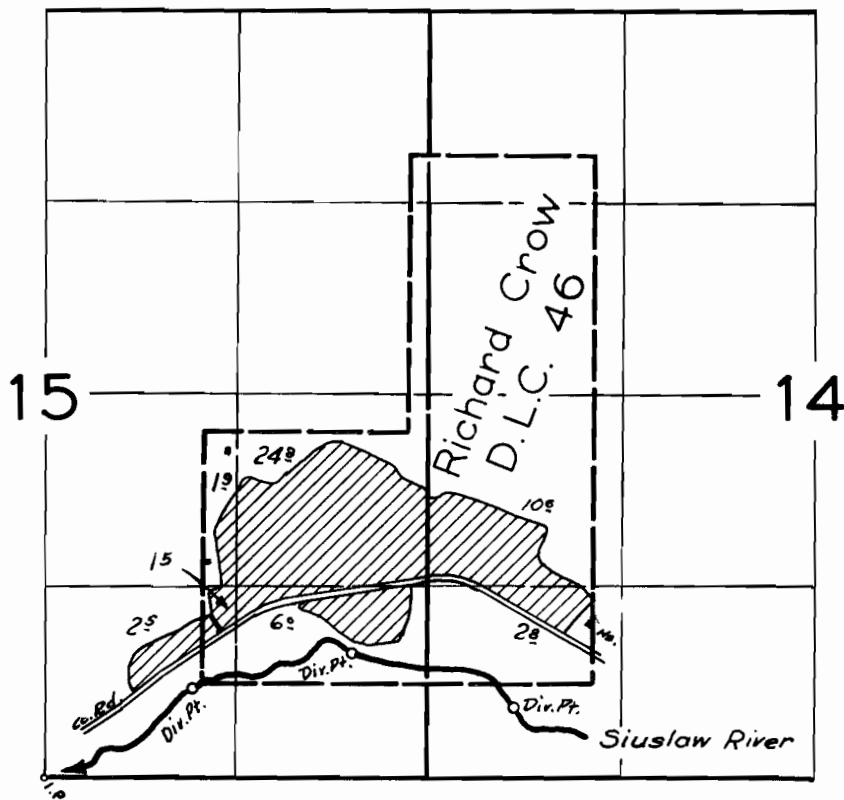

**FINAL PROOF SURVEY**  
UNDER

Application No. 28389. Permit No. 22395.  
IN NAME OF

*GEORGE L. & ROSS B. DEY*

Surveyed Mar. 25 1959, by *R. Jackson*