


T. 13S. R. 20E. W.M.

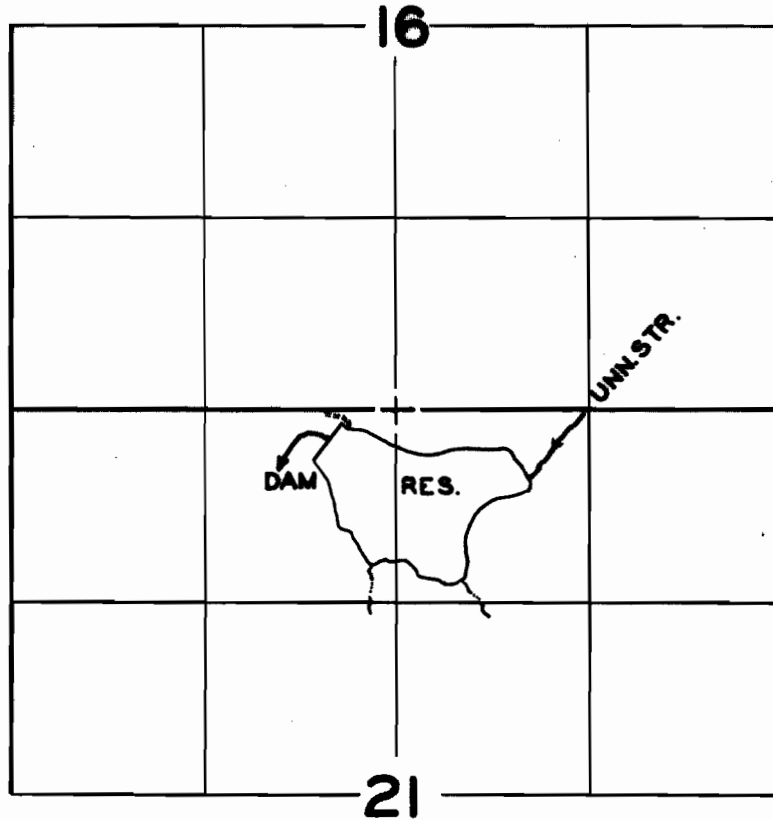

FINAL PROOF SURVEY

UNDER

R-28812

R-1575

Application No. ~~28895~~ Permit No. 22717

IN NAME OF

PRINEVILLE CHAPTER, IZAAC WALTON LEAGUE OF AMERICA

Surveyed AUG. 9, 1957, by C.O. BARTELS