


T.37S.R.IW.W.M.

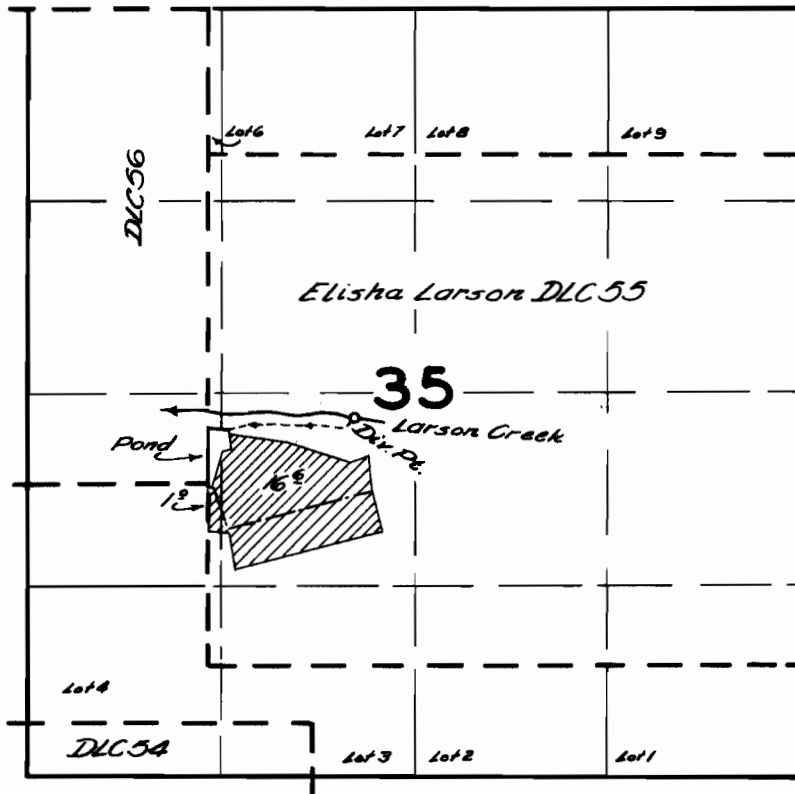

**FINAL PROOF SURVEY**  
UNDER

Application No. <sup>R-26969</sup> 26970... Permit No. <sup>R-1585</sup> 22729...  
IN NAME OF

.....*Oscar J. Gysin*.....

Surveyed *May 18* 1959, by *C.O. Bartels*