


T.34 S.R. I.W.W.M.

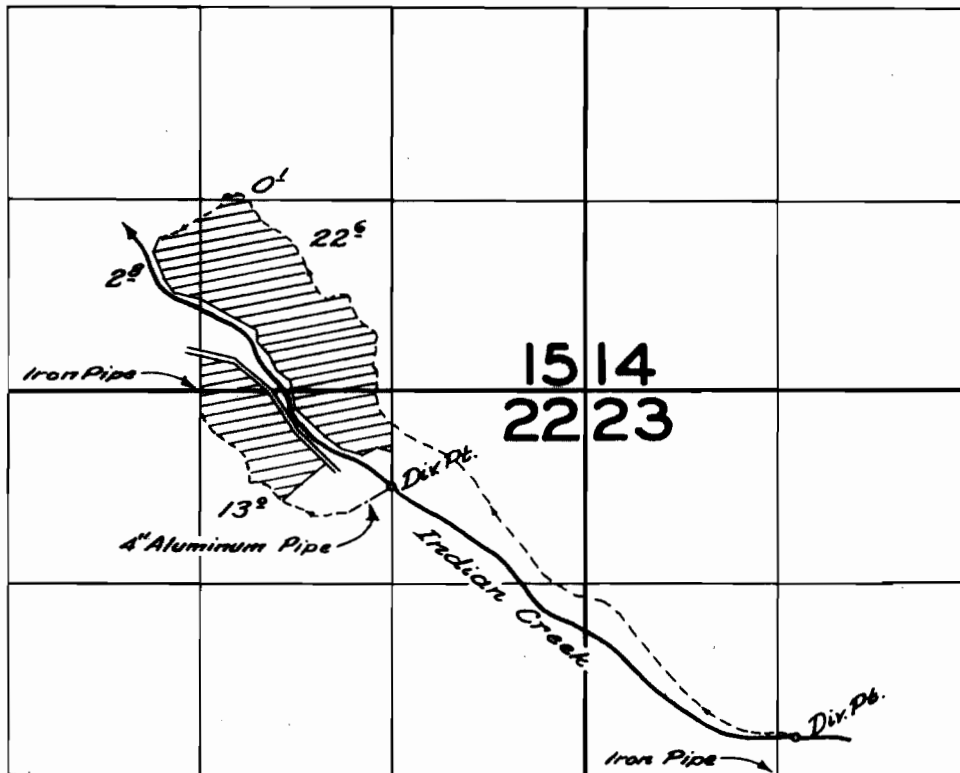

FINAL PROOF SURVEY
UNDER

Application No. 28907 Permit No. 22757
IN NAME OF

CHARLES WINKLE

Surveyed May 24/11 1959, by C.O. Baitle