


T. 35S.R.6-7W.W.M.

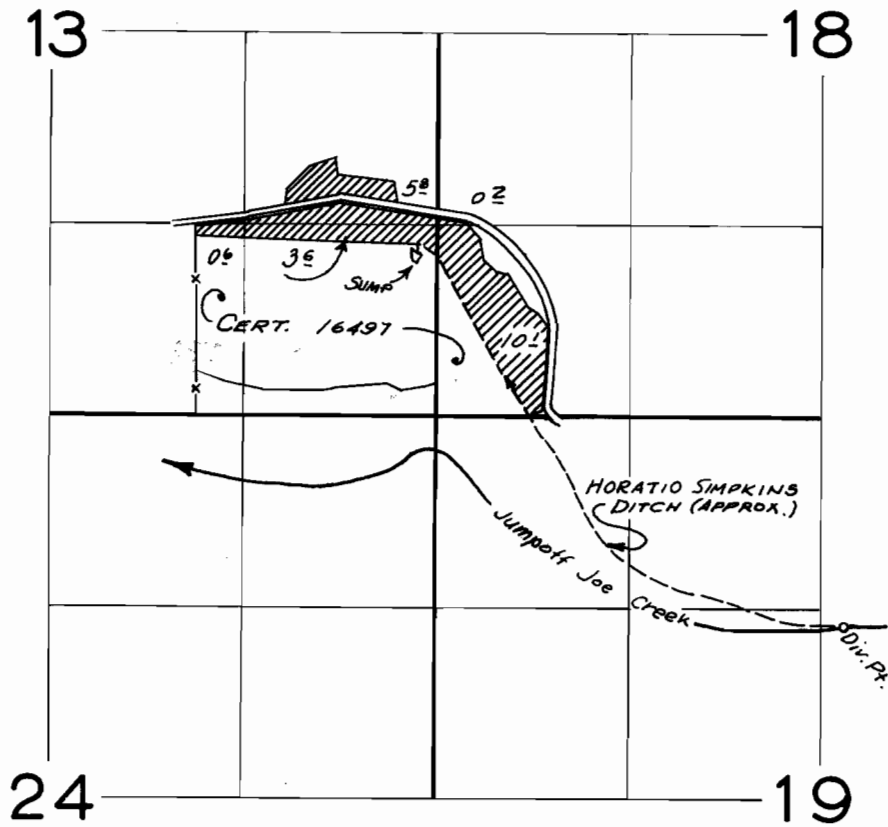

FINAL PROOF SURVEY
UNDER

Application No. 29.291. Permit No. 23025.
IN NAME OF

..... CONRAD O. NYSTROM

Surveyed July 22 1959, by *R. Jackson*