


T.16S. R.39&40E.W.M.

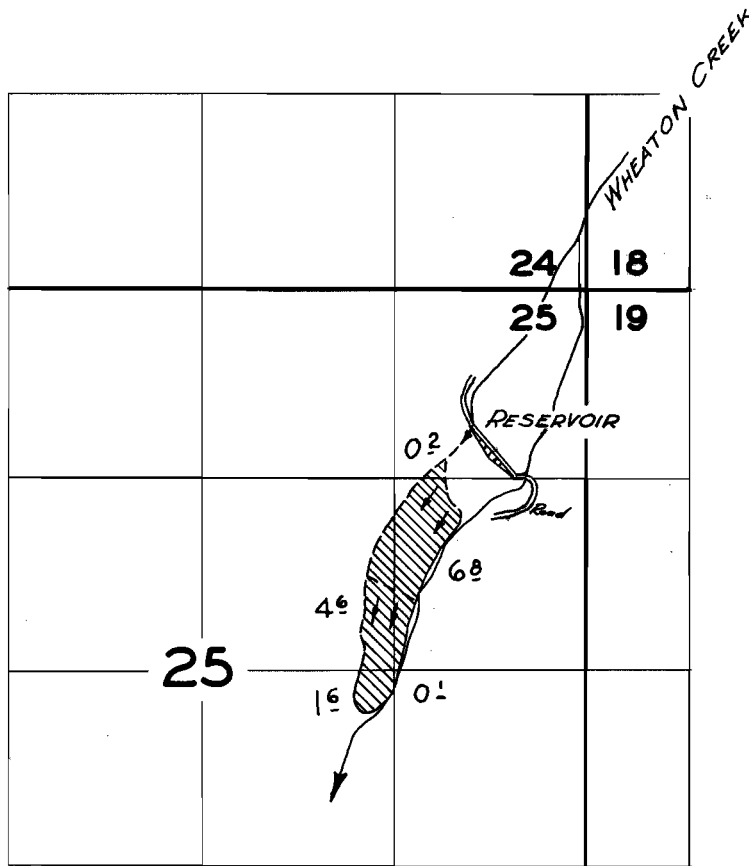

FINAL PROOF SURVEY
UNDER

R-23406 R-1642
Application No. 23407 Permit No. 23045
IN NAME OF

BERT W. HAWKINS

Surveyed 27 Oct. 1958, by C.O. Bartels.