


T. 33 S. R. 6 W. W. M.

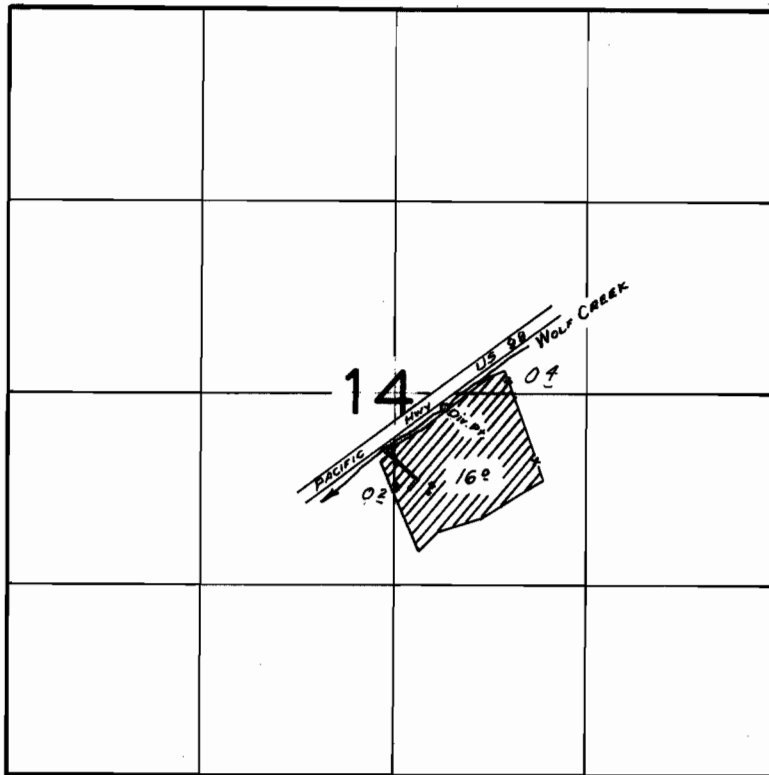

FINAL PROOF SURVEY
UNDER

Application No. 29519. Permit No. 23207.
IN NAME OF

CLYDE & ELIZABETH CRISSMAN

Surveyed July 15, 1959, by R. Jackson