


T. 12S. R. 5 W. W.M.

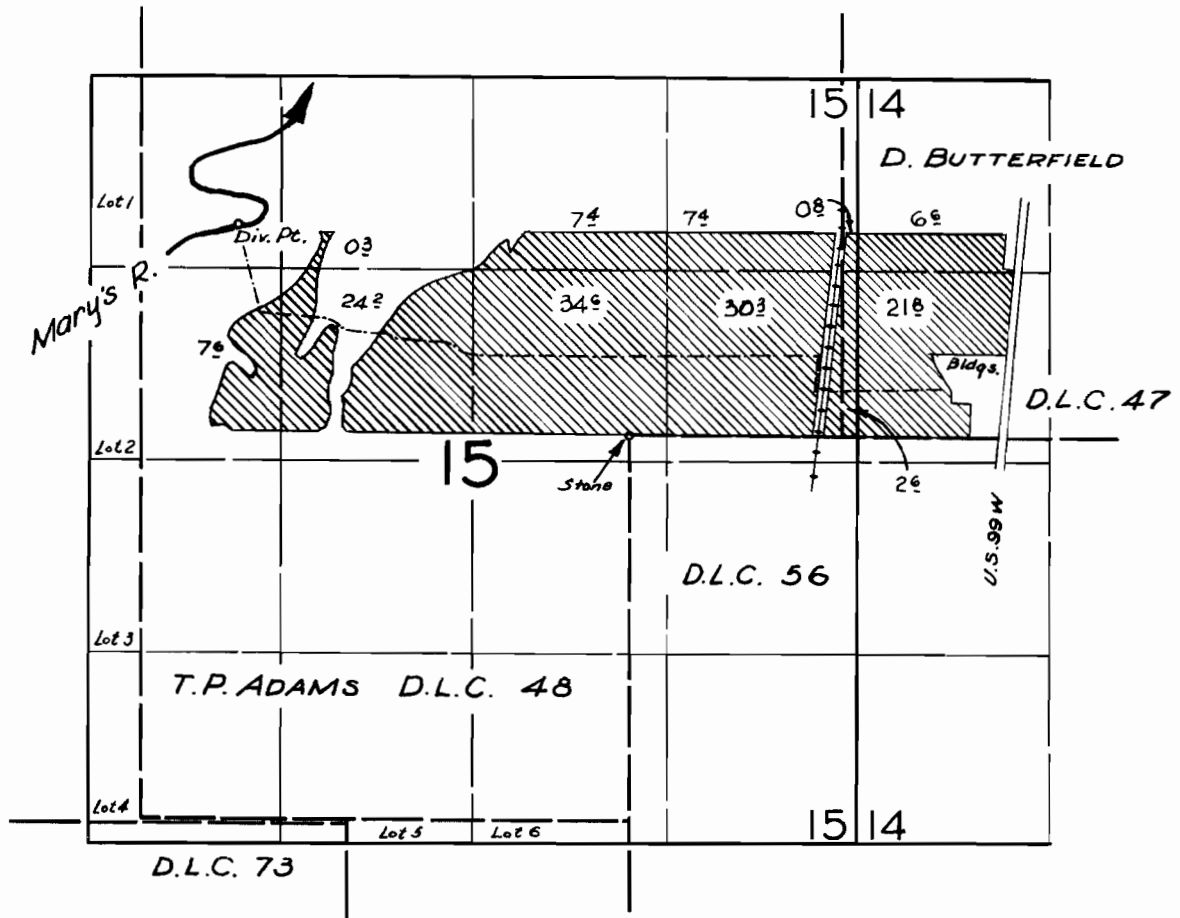

FINAL PROOF SURVEY
UNDER

Application No. 29884 Permit No. 23534
IN NAME OF

Gene D. Minty

Surveved 10 Mar. 1959, by *R. Jackson*