


T.17S. R. 3W.W.M.

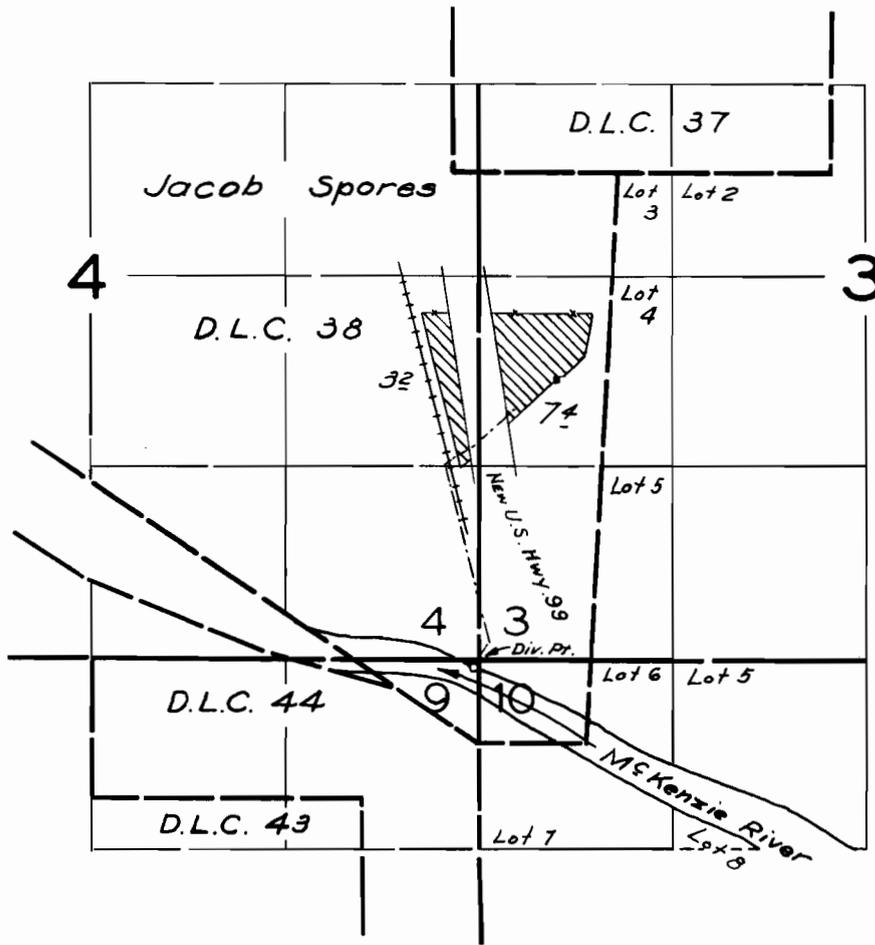

FINAL PROOF SURVEY
UNDER

Application No. 29965... Permit No. 23606
IN NAME OF

NIELS O. & ELSIE M. EGGE

Surveyed 31 March 1959, by *R.H. Jackson*