


T.37S. R. 4W.W.M.

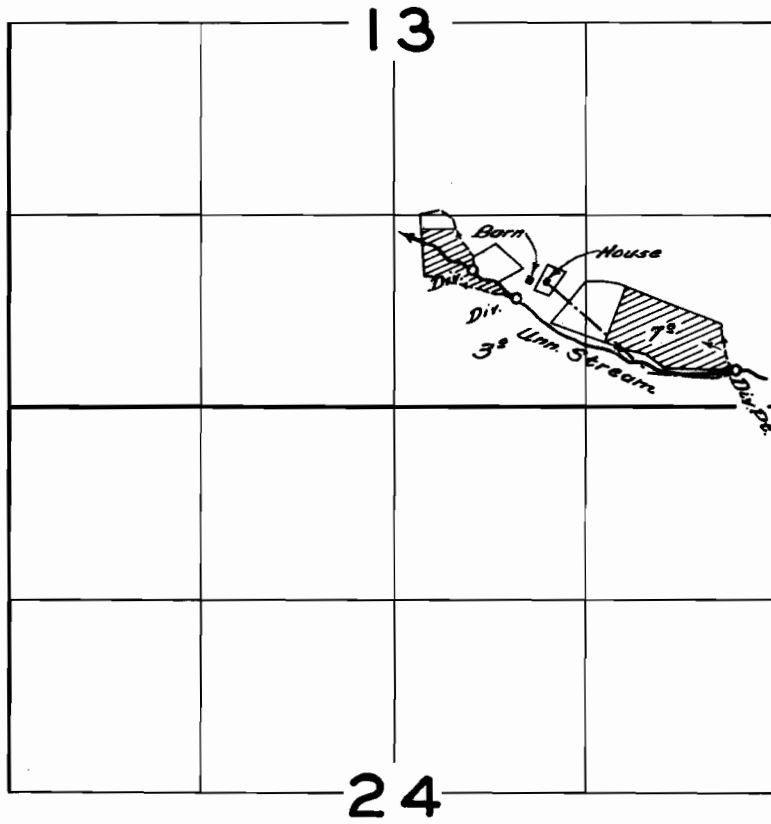

FINAL PROOF SURVEY
UNDER

Application No. 30042 Permit No. 23688
IN NAME OF

..... ELLA J. ELDER

Surveyed May 15 1959, by C. O. Baugh