


T. 35 S. R. 5 W. W. M.

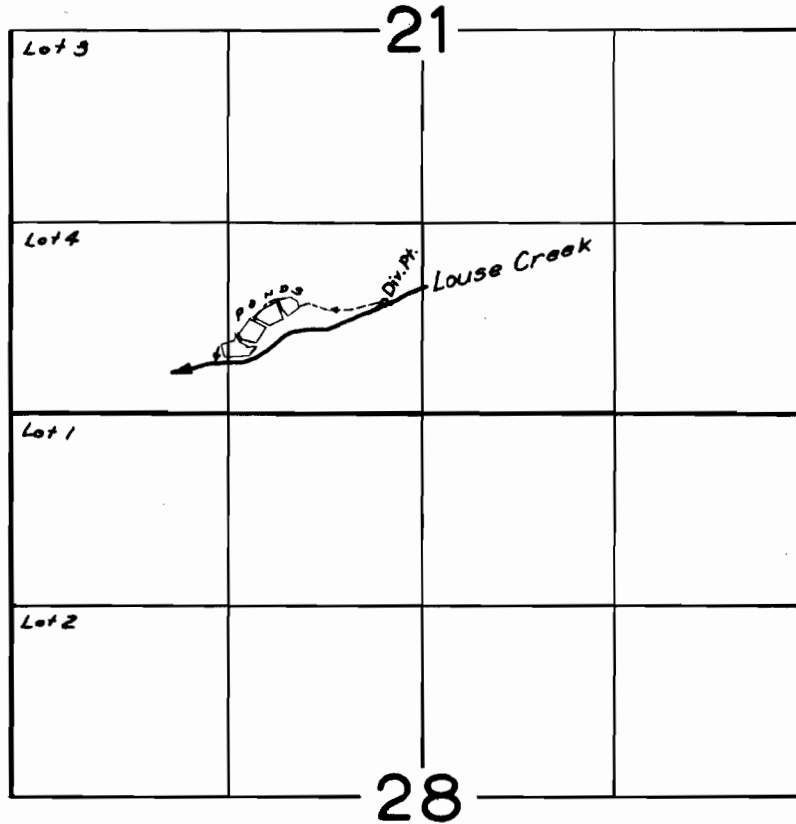

FINAL PROOF SURVEY
UNDER

Application No. ^{R-30176} ~~30177~~ Permit No. ^{R-1792} ~~23807~~
IN NAME OF

C. K. SOUTHWORTH

Surveyed July 17, 1959, by R. H. Jackson