


Permit: S 23807
Volume: 5
Strm: LOUSE CR
Trib: JUMPOFF JOE CR
Priority: 8/08/55

T.35S.R.5W.W.M.

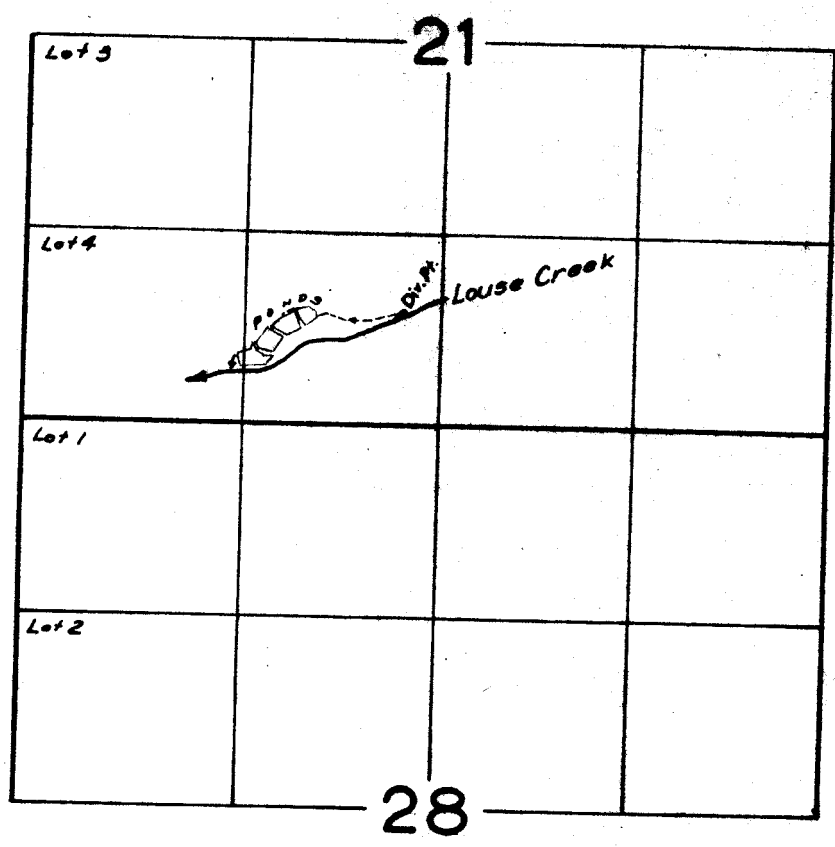

FINAL PROOF SURVEY
UNDER

Application No. R-30176 30177 Permit No. R-1792 23807
IN NAME OF

C. K. SOUTHWORTH

Surveyed July 17, 1959, by R. H. Jackson