


T.20S. R.2 W.W.M.

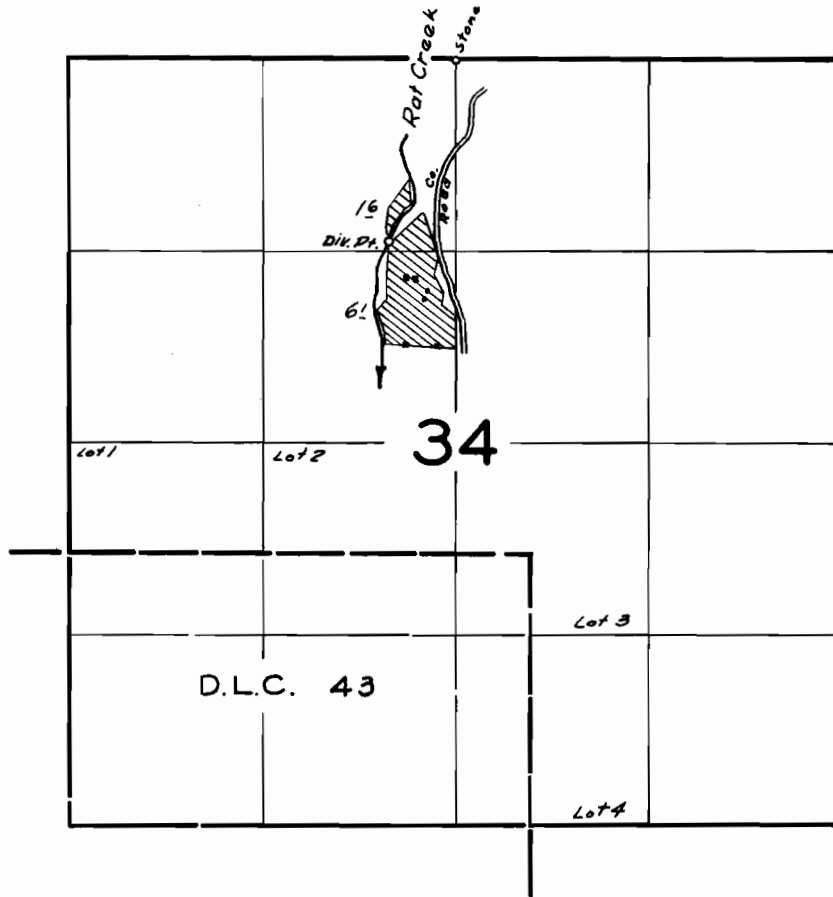

FINAL PROOF SURVEY
UNDER

Application No. 30489 ... Permit No. 24013 ...
IN NAME OF

E.W. DAVENPORT

Surveyed 24 Mar. 1959, by *R.H. Jackson*