


T. 22 S. R. 3 W. W. M.

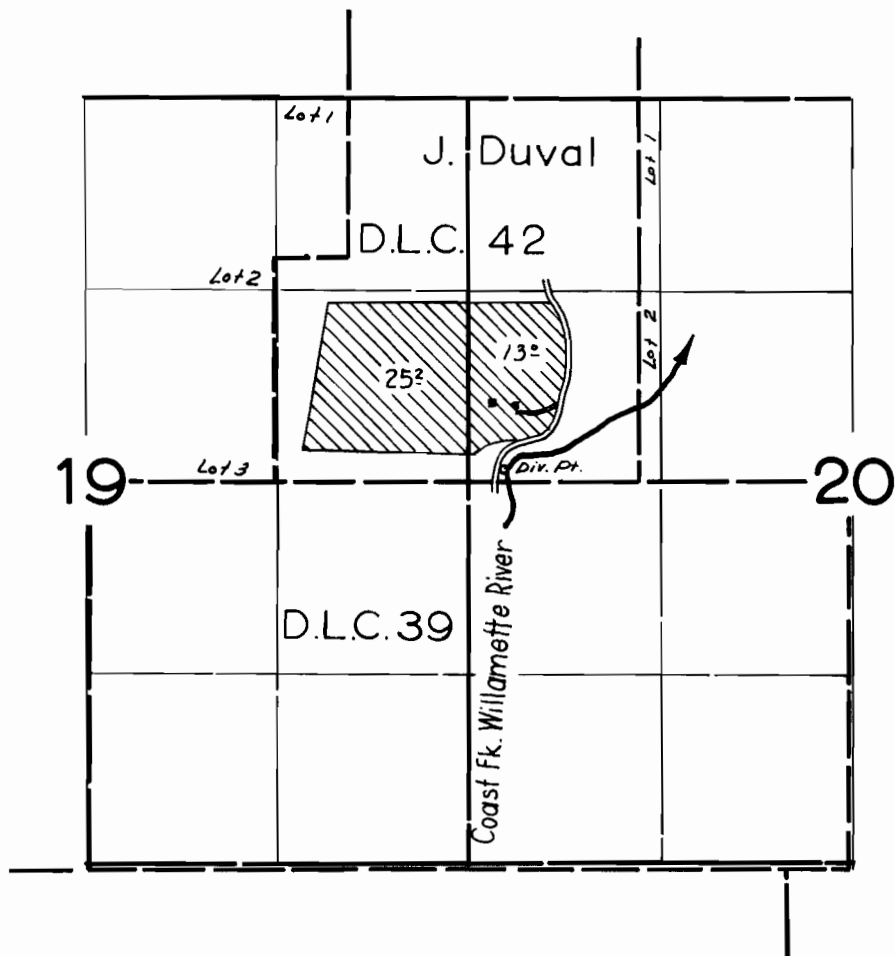

FINAL PROOF SURVEY
UNDER

Application No. 30671 Permit No. 24150
IN NAME OF

LLOYD A. LINDSEY

Surveyed Mar. 24, 1959, by *R. Jackson*