


T.19S. R.3W.W.M.

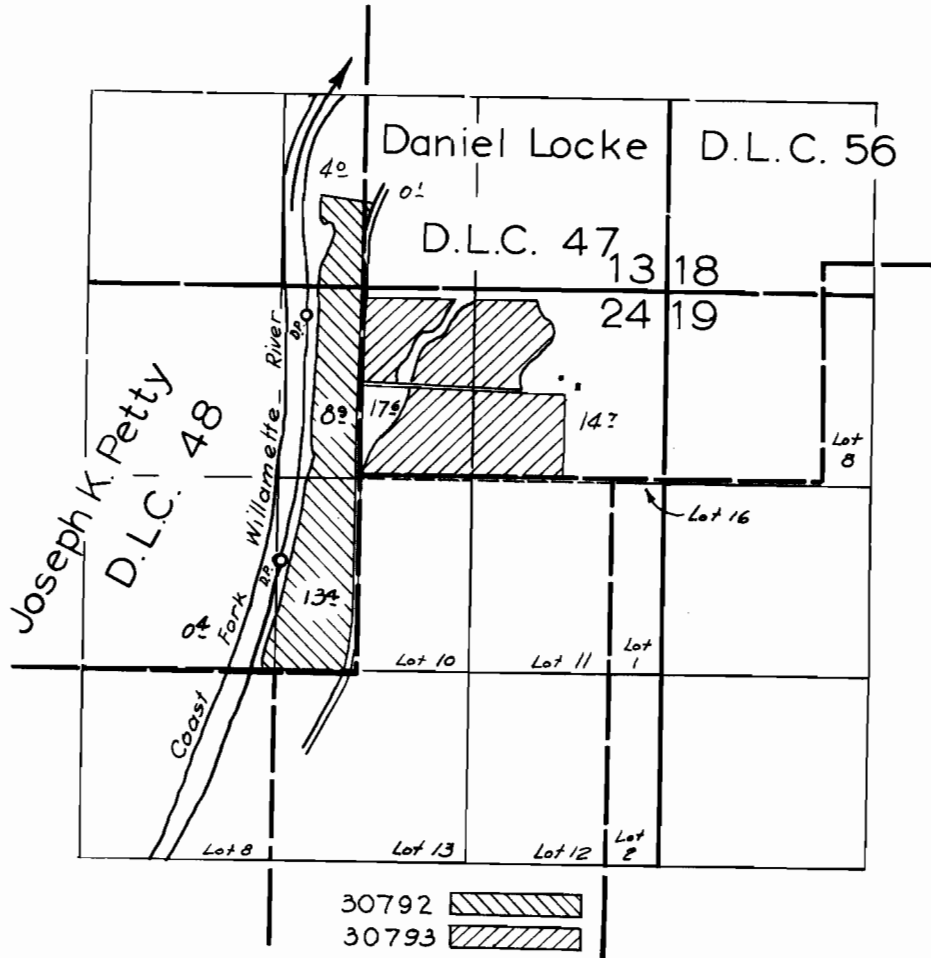

FINAL PROOF SURVEY
UNDER

Application No. 30792 24244
30793 Permit No. 24245
IN NAME OF

A.W. BARTEL

Surveyed Mar. 26 1959, by R. Jackson