


T. 2 N. R. 3 W. W. M.

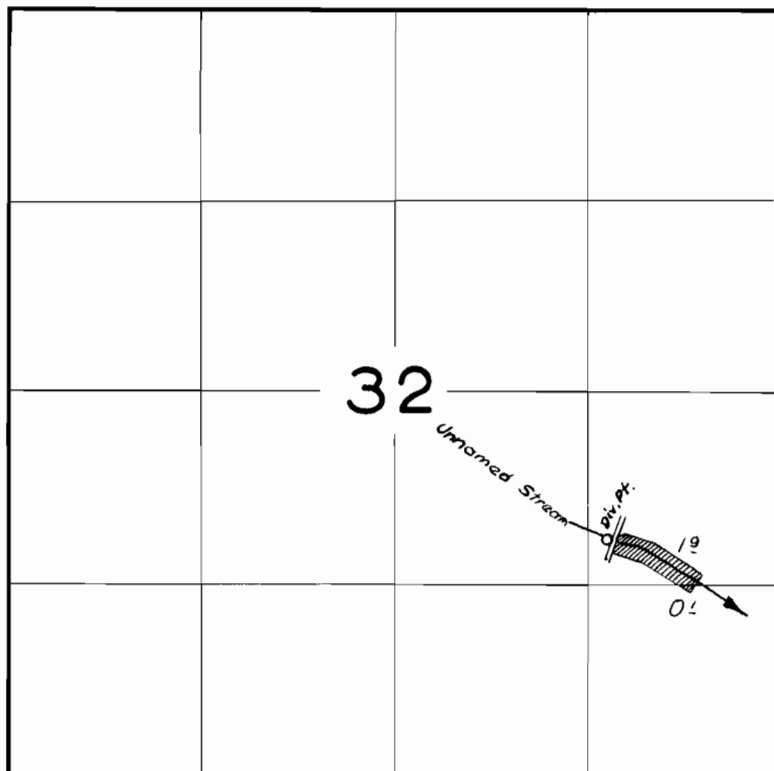

FINAL PROOF SURVEY
UNDER

Application No. 30787 .. Permit No. 24313 ..
IN NAME OF

E. & OTTO REIBEN

Surveyed 28. May 1959, by *R. Jackson*