


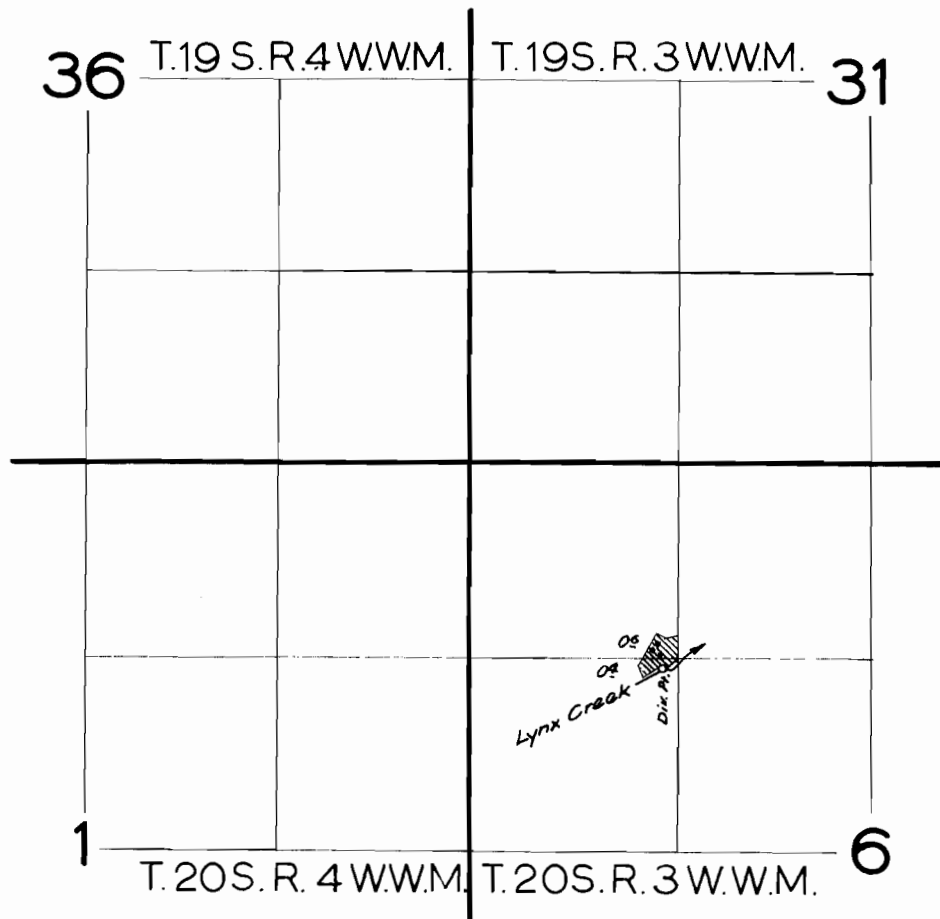

FINAL PROOF SURVEY UNDER

Application No. 30858... Permit No. 24366
IN NAME OF

C. V. BEACH

Surveyed 26 March 1959, by *R. Jackson*