


T. 1 N. R. 3 W. W. M.

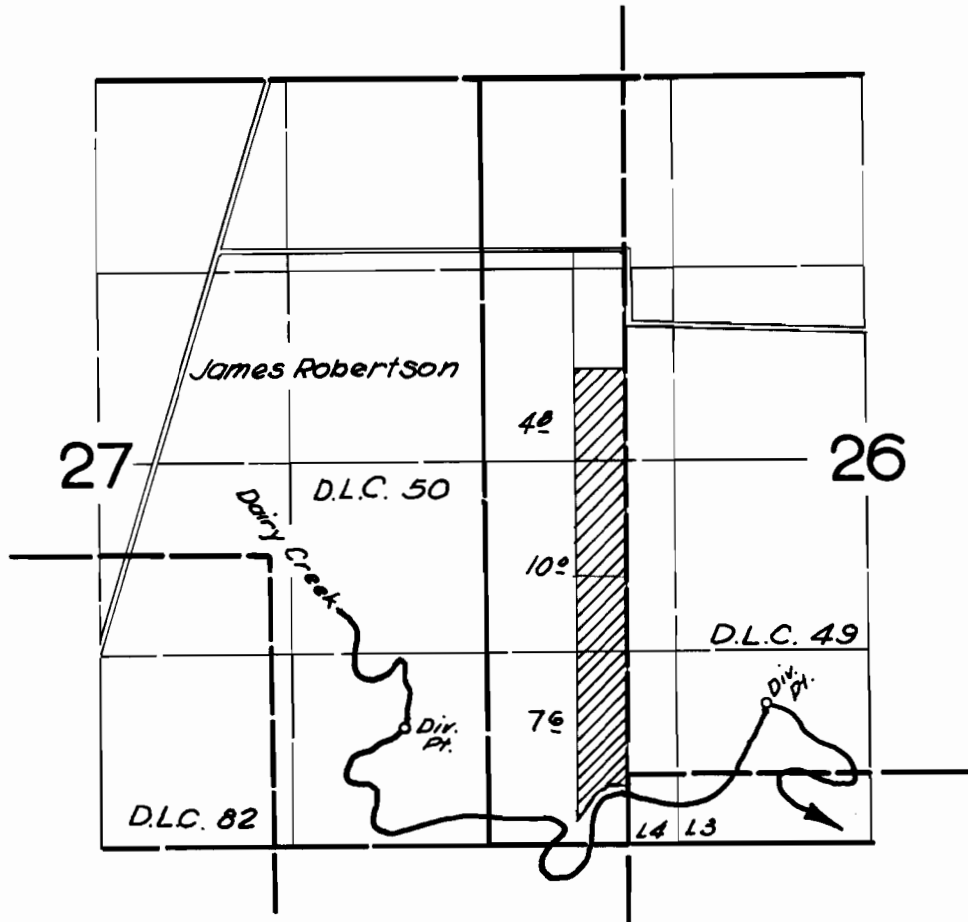

FINAL PROOF SURVEY
UNDER

Application No. 31051 ... Permit No. 24399.
IN NAME OF

CECIL N. KINDEL

Surveyed 26 May 1959, by *R. Jackson*