


# T.39S. R.19-20E.W.M.

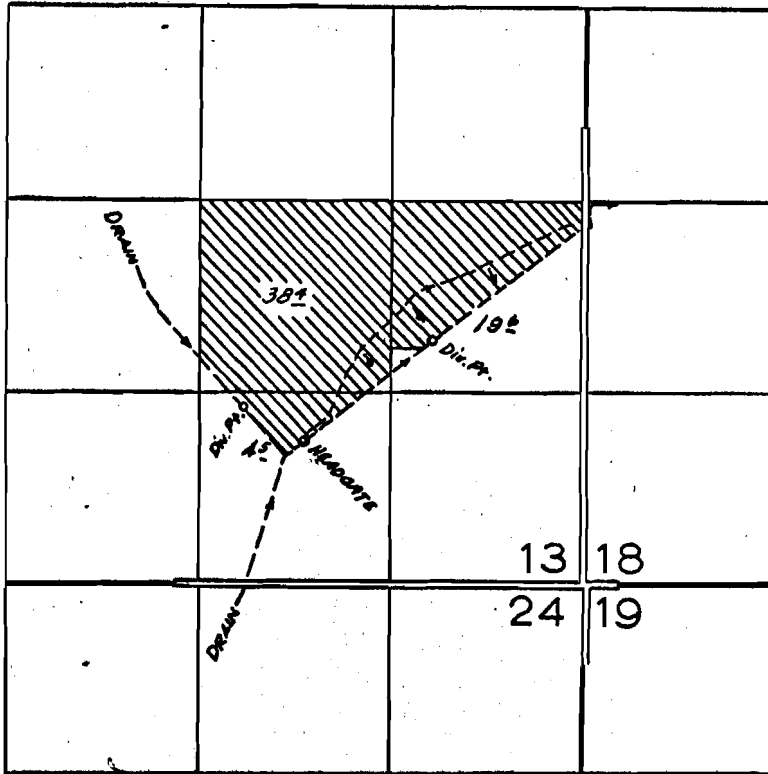

## FINAL PROOF SURVEY UNDER

Application No. 24791... Permit No. 24489  
IN NAME OF

*ELMO ANGELE*

Surveyed May 13, 1959, by *R. Jackson*

39-19,20 ✓