


T.9S. R.10W.W.M.

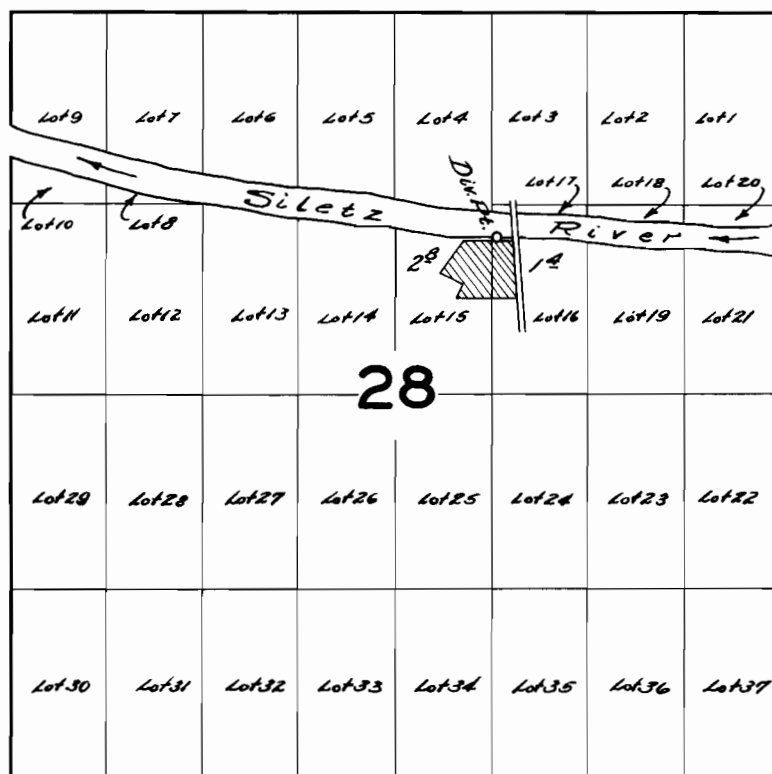

FINAL PROOF SURVEY
UNDER

Application No. 31173 Permit No. 24602
IN NAME OF

RAY H. HOINESS

Surveyed April 15 1959, by C.O. Burtch