


T. 1N. R. 3 W.W.M.

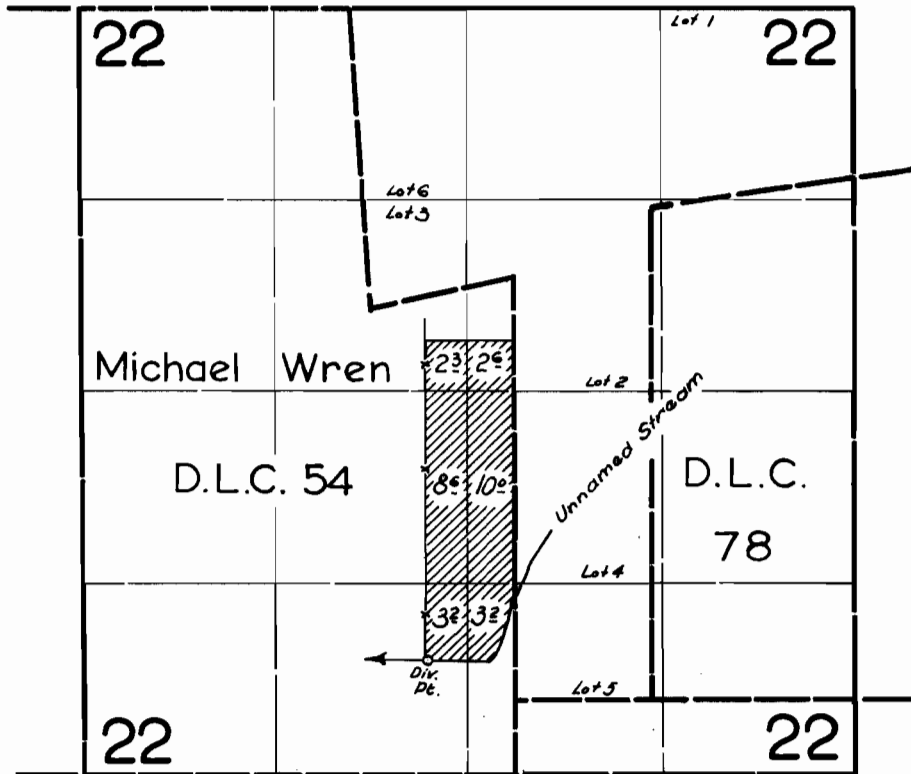

**FINAL PROOF SURVEY**  
UNDER

Application No. 3/342 Permit No. 24698  
IN NAME OF

A. F. & FRANCES W. DELPLANCHE

Surveyed 26 May 1959, by *R.H. Jackson*