


T.20S. R.5 W.W.M.

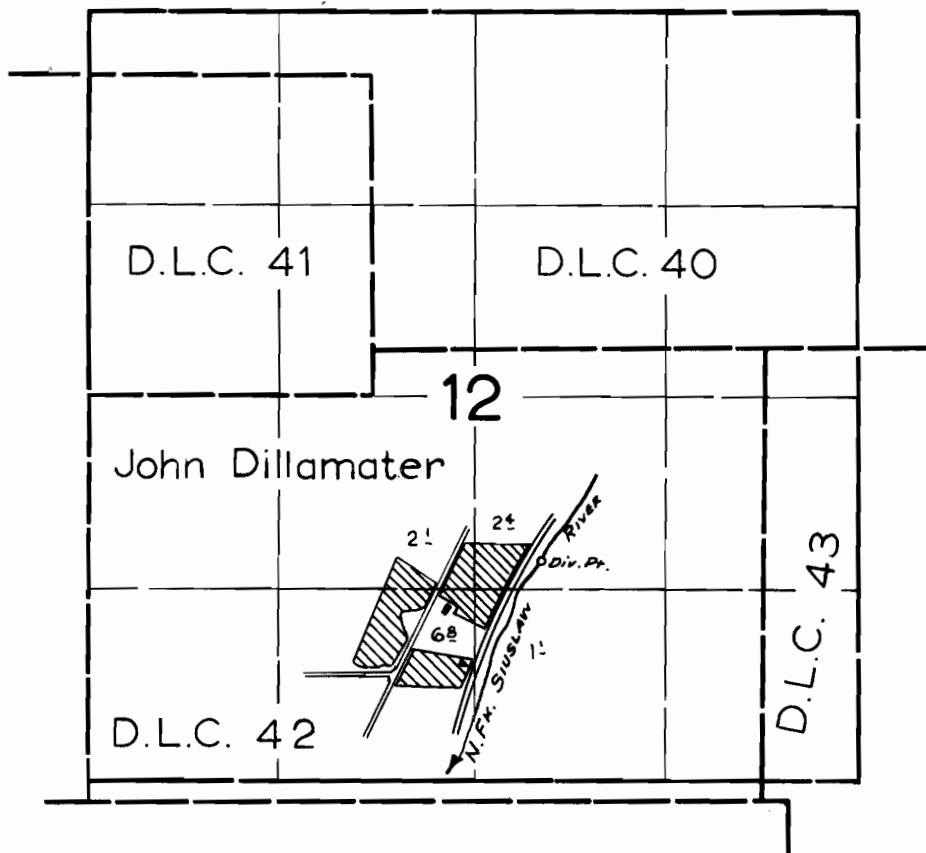

FINAL PROOF SURVEY
UNDER

Application No. 31772 Permit No. 25230
IN NAME OF

PAUL R. WILLIAMSON

Surveyed Mar. 25 1959, by *R. Jackson*