


25312  
26881

# T.40S. R.19 E.W.M.

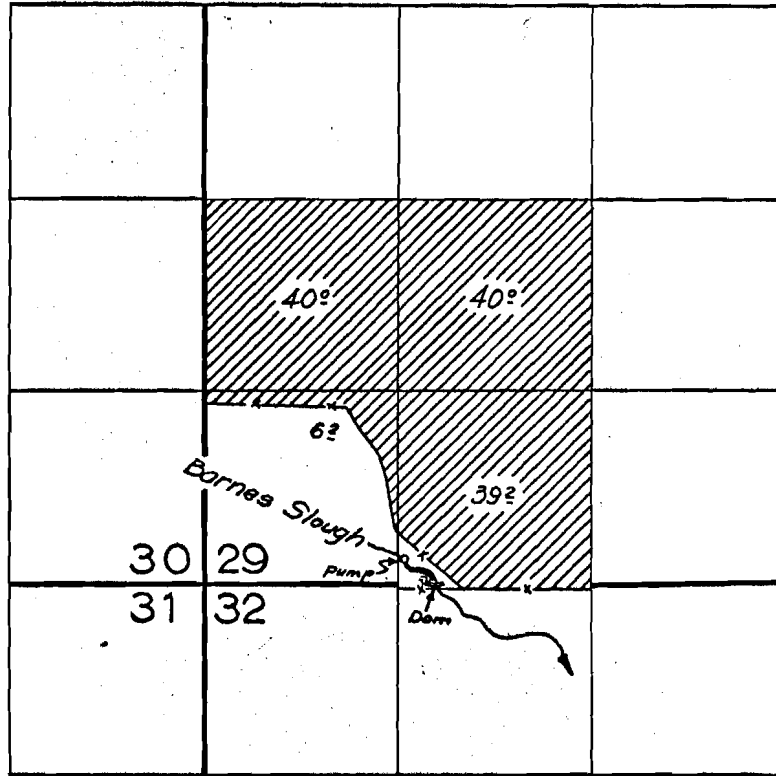

## FINAL PROOF SURVEY UNDER

Application No. 31.98.2... Permit No. 25312...  
IN NAME OF

C. V. FENIMORE

Surveyed May 7, 1959, by R. Jackson

40-19 ✓

CHZ-36K-185