


T.17S.R.9 W.W.M.

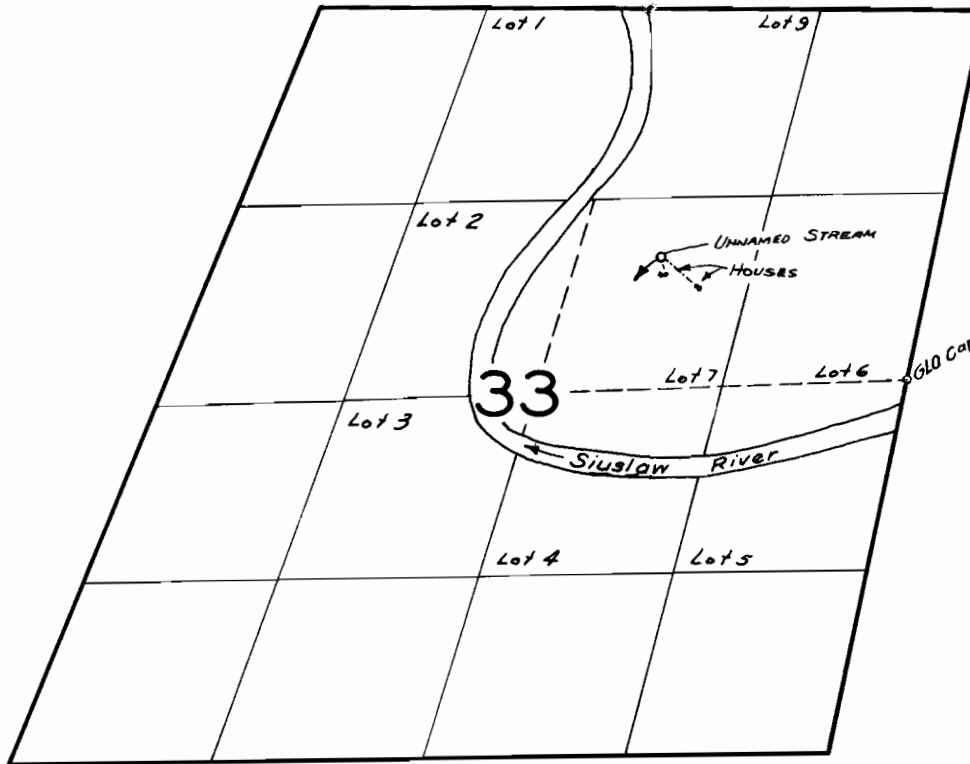

FINAL PROOF SURVEY
UNDER

Application No. 31656... Permit No. 25026
IN NAME OF

LOUIS O. & NORA OLSON

Surveyed April 10 1959, by *R. Jackson*