


T. 11S. R. 2W. W.M.

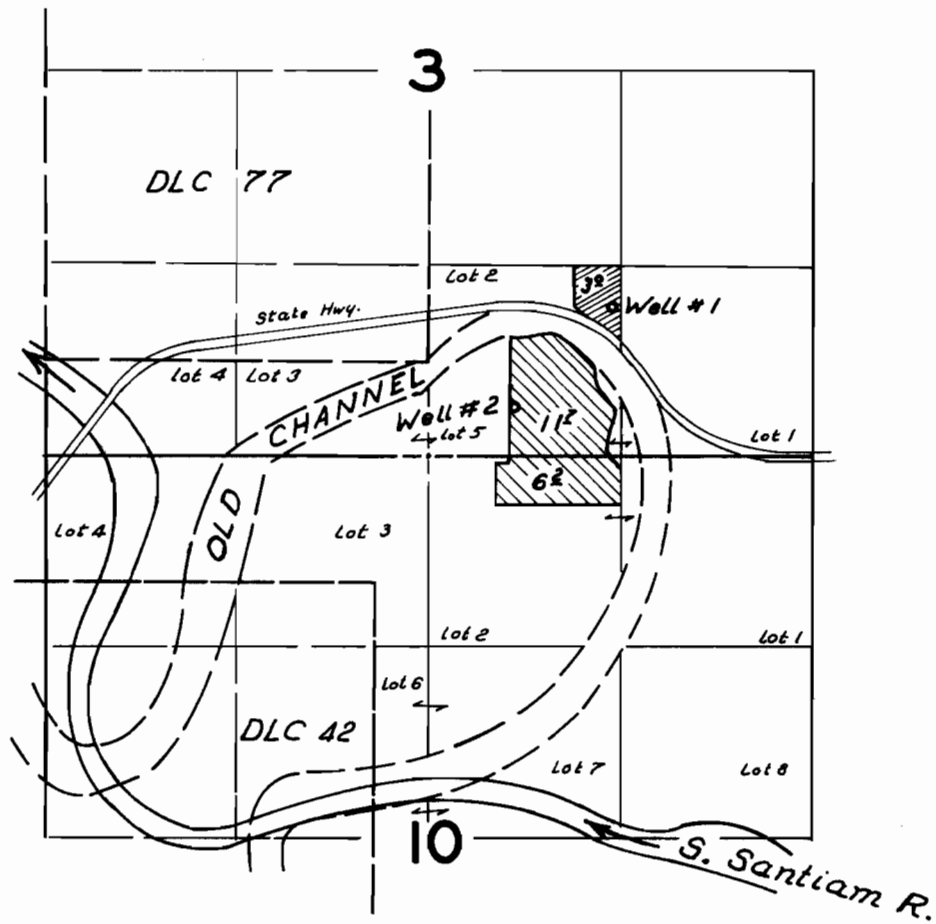

FINAL PROOF SURVEY

UNDER

Application No. 0326 Permit No. 0216

IN NAME OF

Philip Van Valkenburgh

Surveyed July 30 1959, by R. H. Jackson