


T. 7S. R. 2W. W.M.

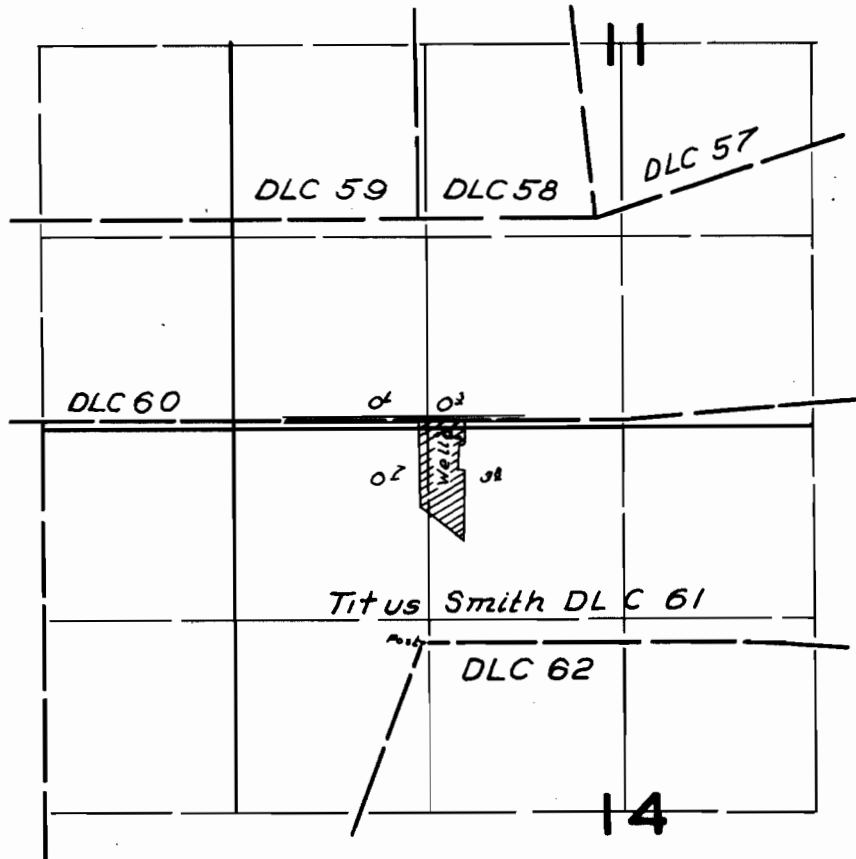

**FINAL PROOF SURVEY**  
UNDER

Application No. *G.328* Permit No. *G.218*  
IN NAME OF

*Clarence O. Braaten*

Surveyed *June 8, 1959*, by *R.H. Jackson*