


T.18S.R.47E.W.M.

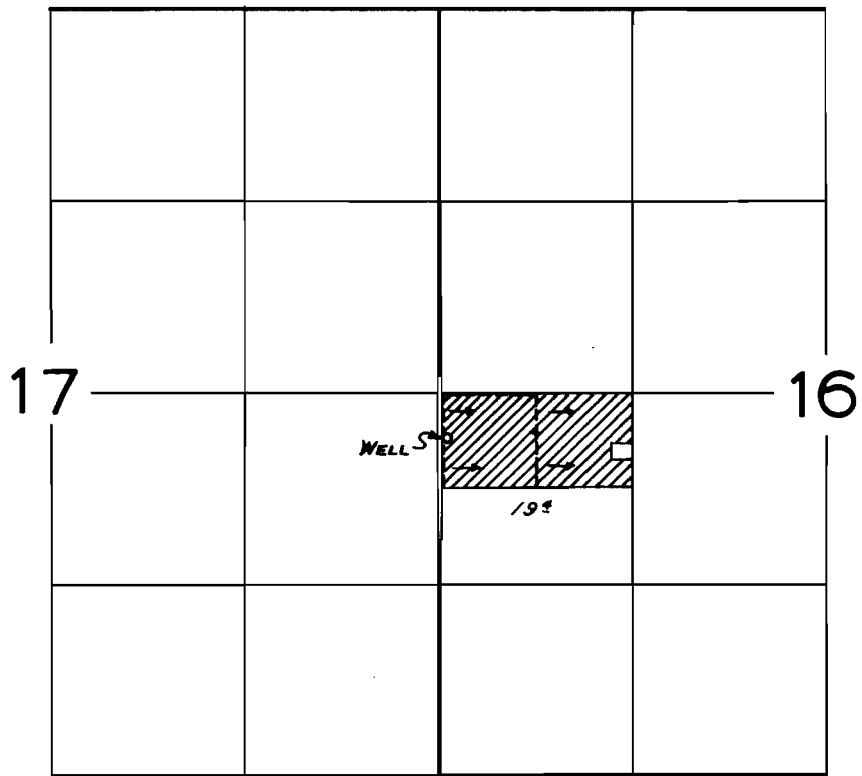

FINAL PROOF SURVEY
UNDER

Application No. G-79.0 Permit No. G-684
IN NAME OF

JERRY T. FUJIWARA

Surveyed Sept. 17, 1959, by *R.H. Jackson*