


T.3 S. R.38E.W.M.

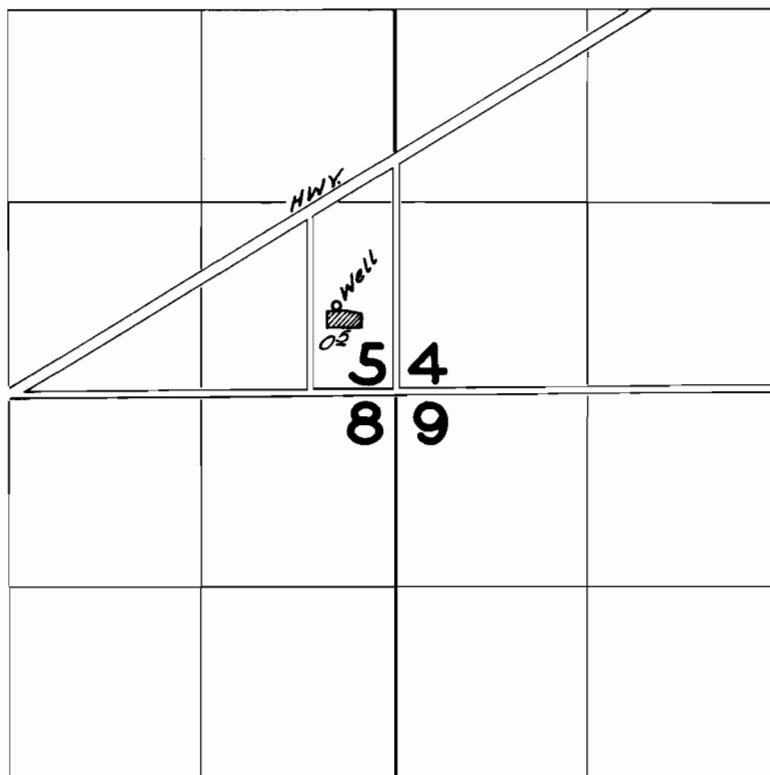

FINAL PROOF SURVEY UNDER

Application No. *G-1107* Permit No. *G-1041*
IN NAME OF

Iver W. Masterson

Surveyed *Aug 4* 1959, by *C.O. Baulto*