


T. 15. R. 9W. W.M.

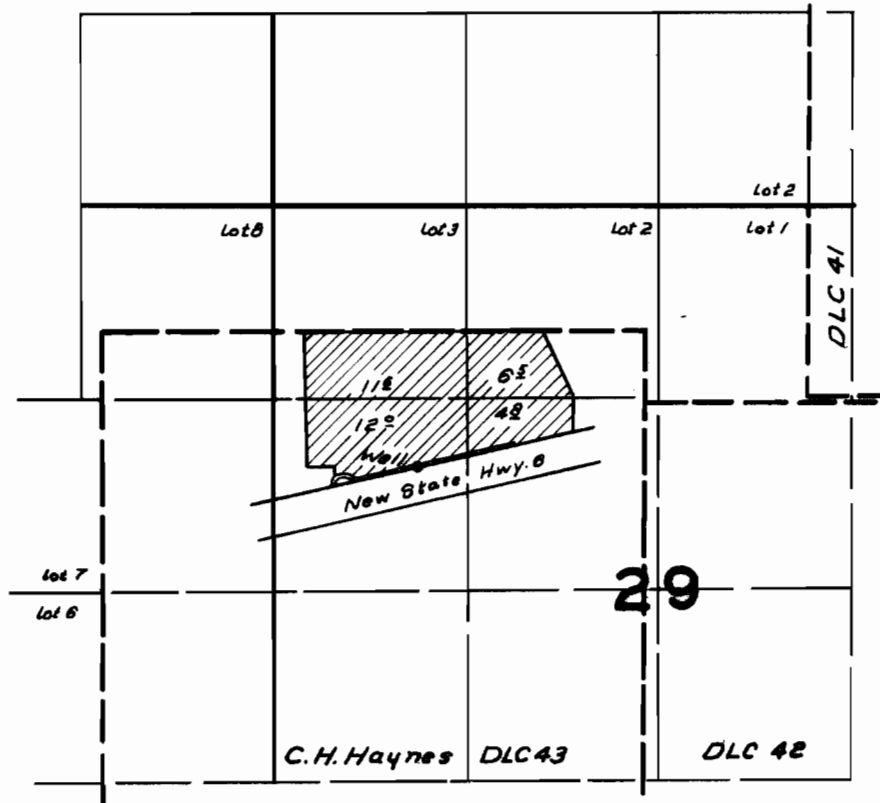

FINAL PROOF SURVEY UNDER

Application No. *G1155* Permit No. *G1053*
IN NAME OF

Norman Burdick

Surveyed *April 17 1959*, by *R. H. Jackson*