


T.3 S. R. 38 E. W.M.

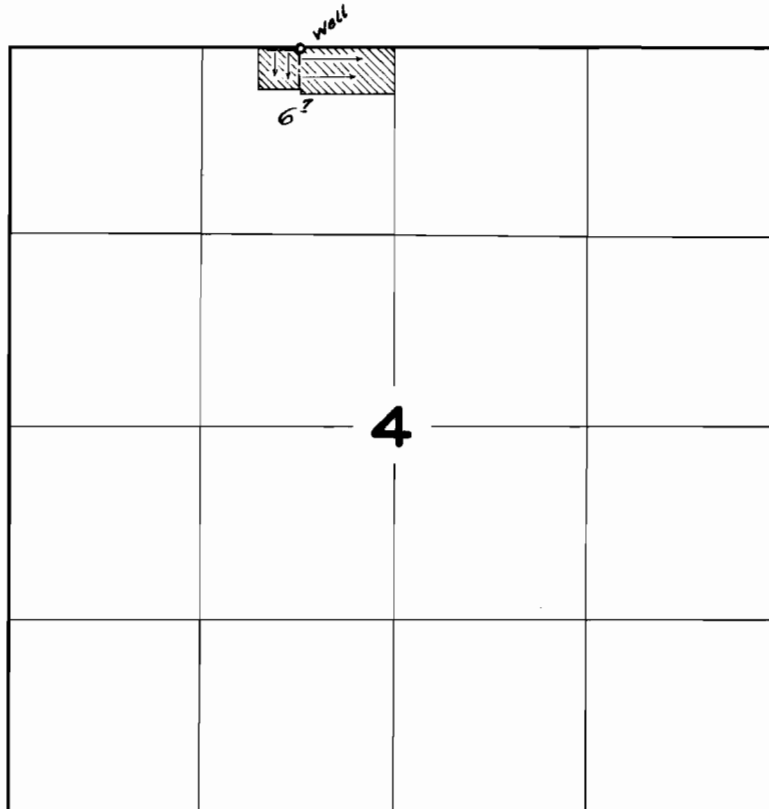

FINAL PROOF SURVEY UNDER

Application No. *G-1178* Permit No. *G-1110*
IN NAME OF

Ellen S. Bear

Surveyed *Aug 4* 1959, by *C.D. Baute*