


T.18S. R.47E.W.M.

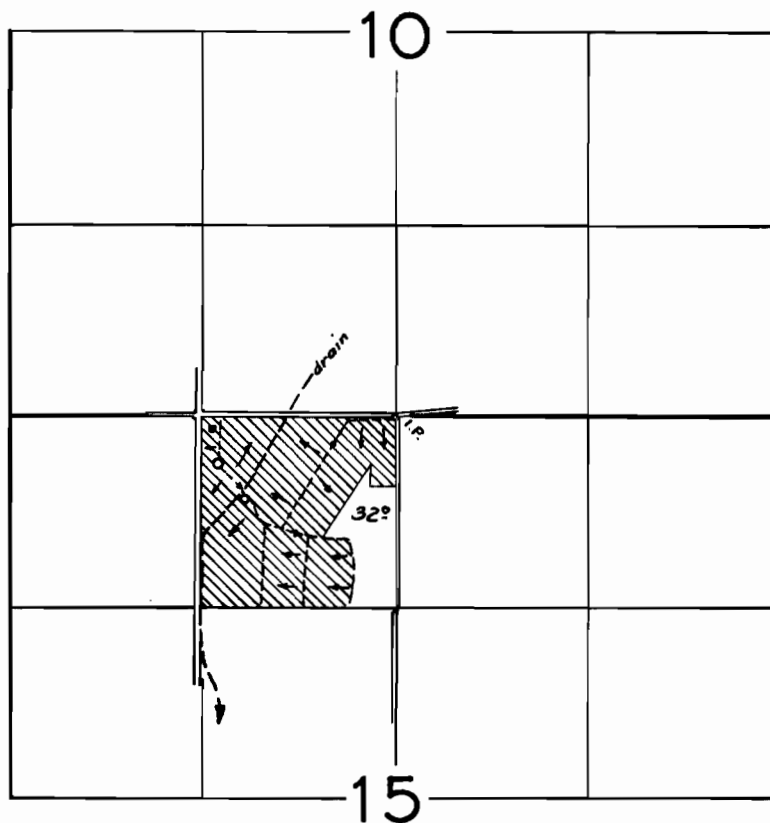

FINAL PROOF SURVEY
UNDER

Application No. G-628. Permit No. G-550.
IN NAME OF

THOMAS S. KANADY

Surveyed Sept. 17, 1959, by L. Jackson