


T. 2 S. R. 4 E. W. M.

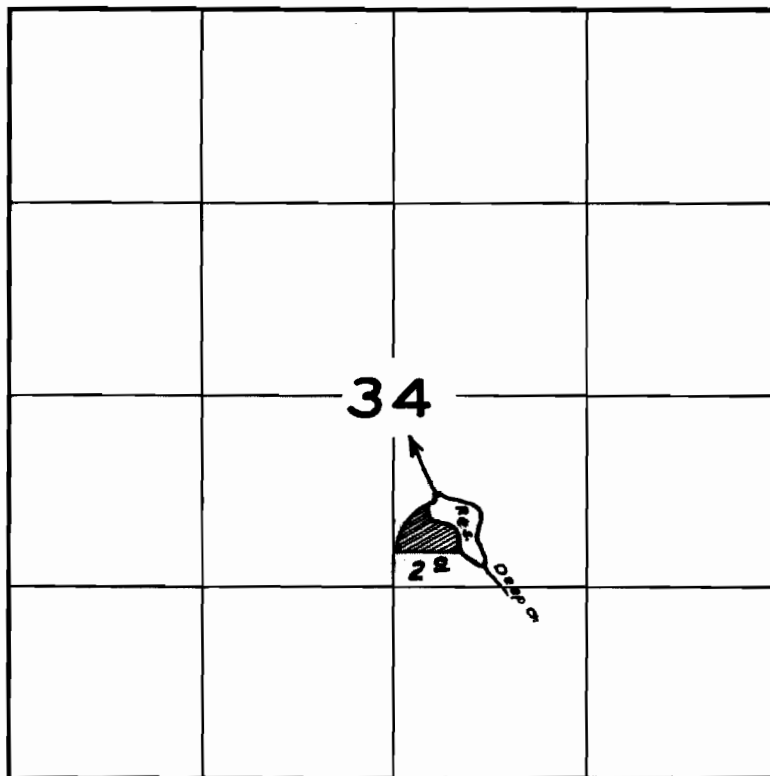

FINAL PROOF SURVEY
UNDER

Application No. *R-16999* *R-708*
16998 Permit No. *12743*
IN NAME OF

Claude I. Sersanous

Surveyed *Aug 25* 1958, by *W.N. Perry*