


T.40S.R.35E.W.M.

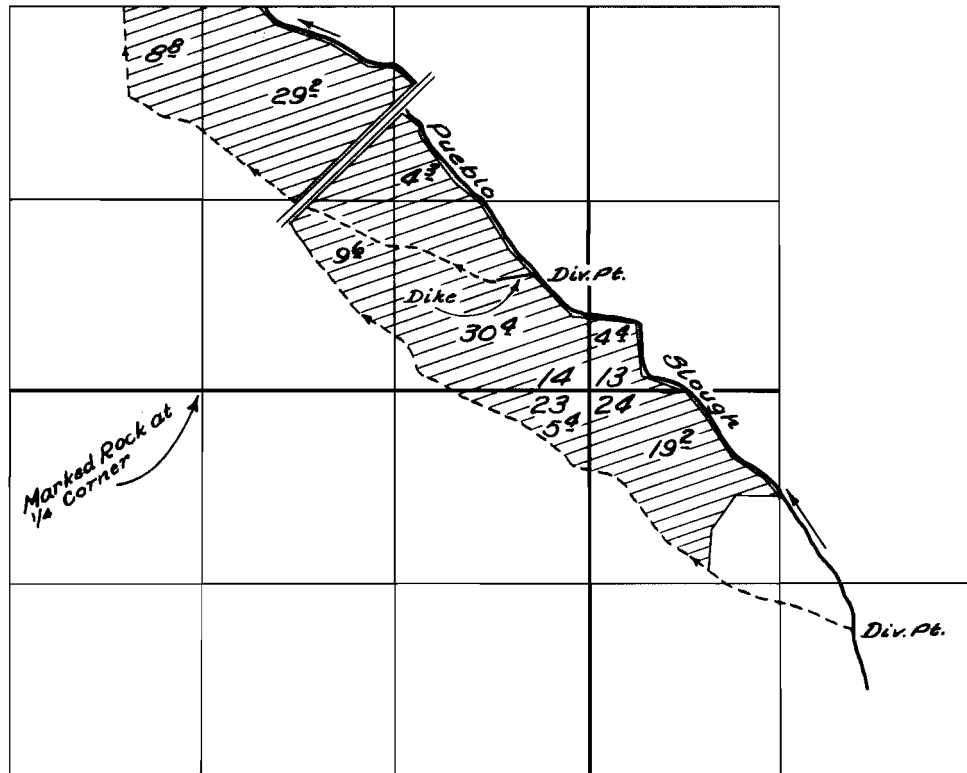

FINAL PROOF SURVEY
UNDER

Application No. 20093 Permit No. 17070
IN NAME OF

Irwin E. Smith

Surveyed July 23 1958 by C.O. Bartleb