


T. 22 & 23S. R. 31&32E. W.M.

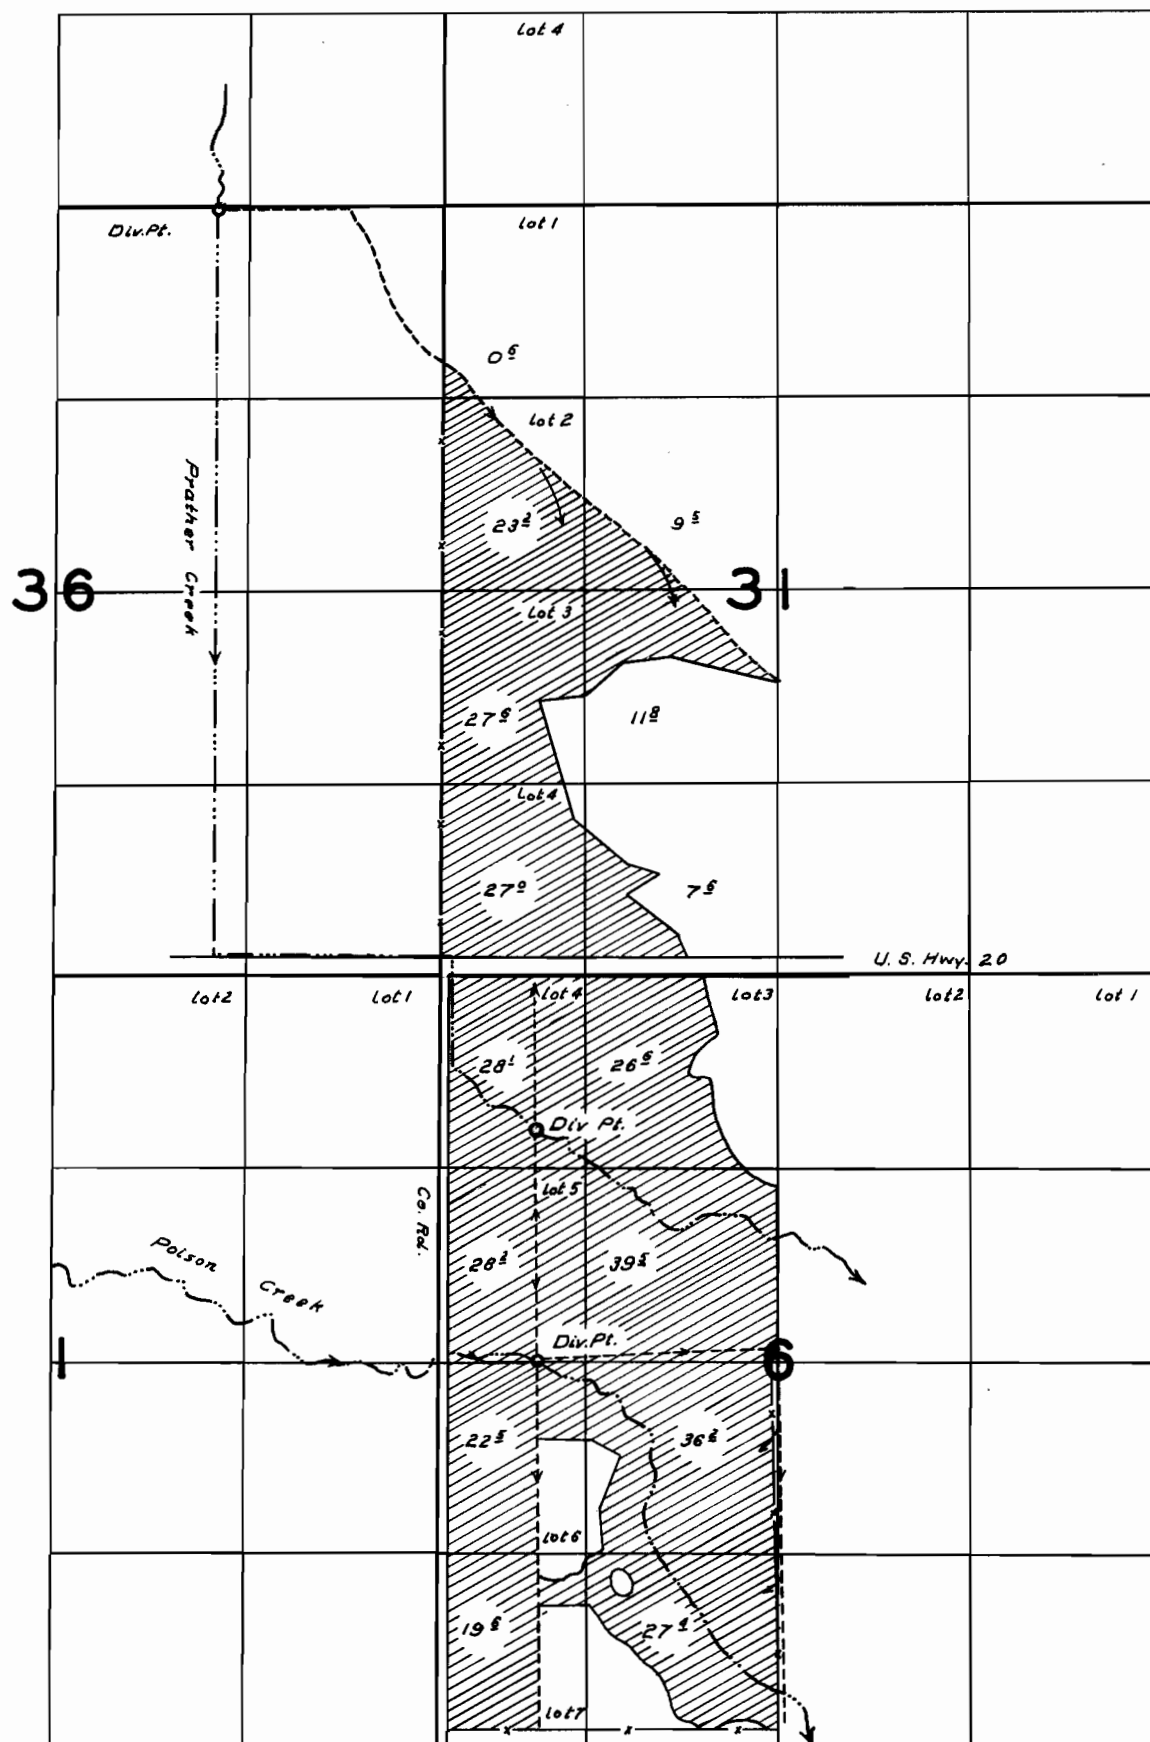

FINAL PROOF SURVEY

FOR

L. S. HEBENER

APPLICATION NO. 2 2079 PERMIT NO. 17527

SURVEYED BY W. N. PERRY ON JULY 25, 1958.