


T.12S.R. 8 W.W.M.

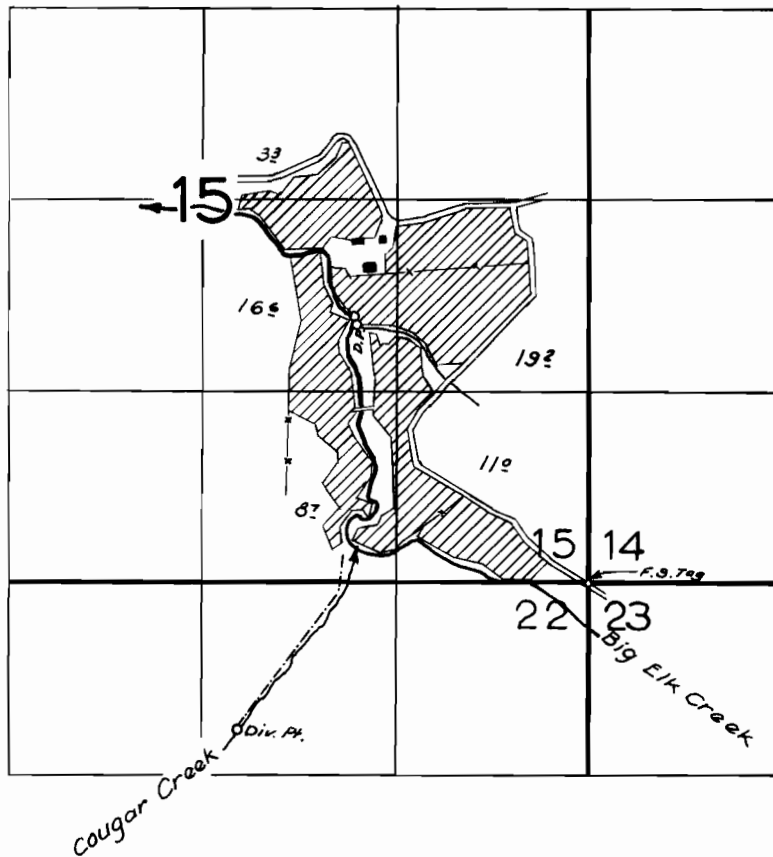

FINAL PROOF SURVEY
UNDER

Application No. 21946 Permit No. 17344
IN NAME OF _____

C.E. JONES

Surveyed 29 April 1959, by RH Jackson