


T. 1 S. R. 2 W. W. M.

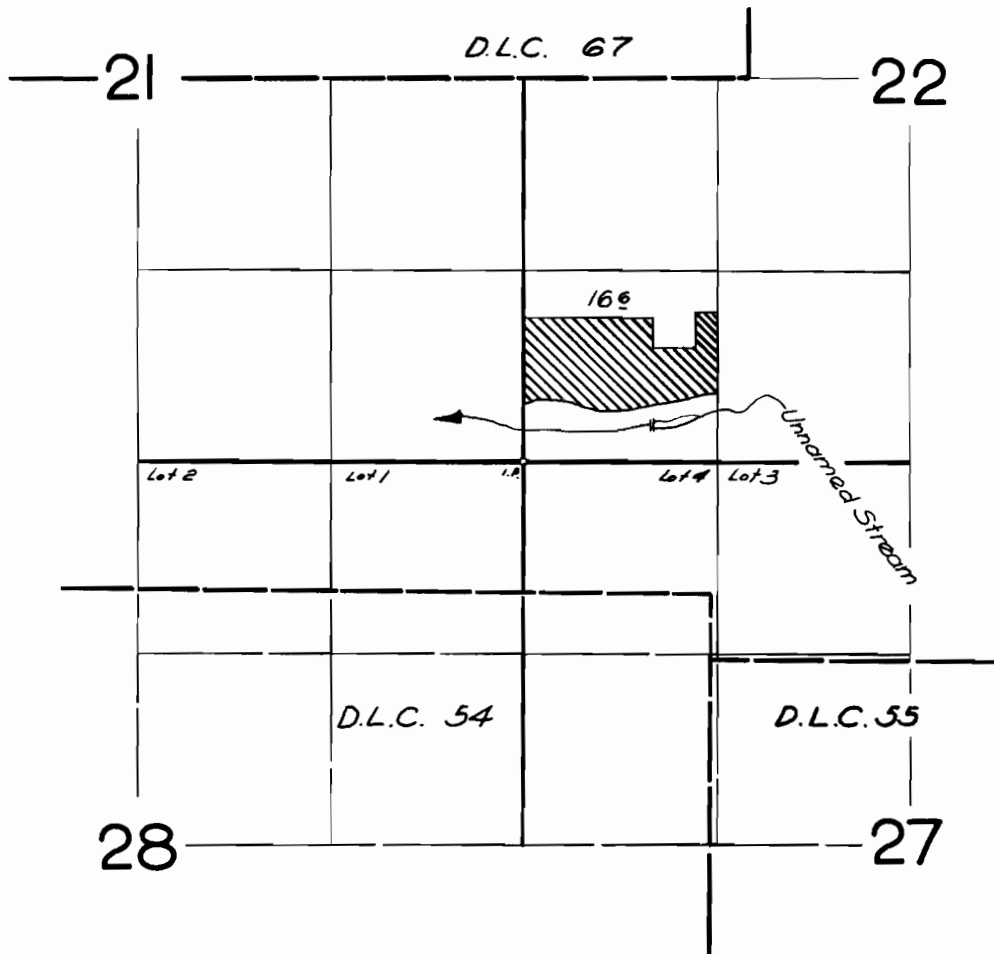

FINAL PROOF SURVEY
UNDER

Application No. 24566 . Permit No. 19321
IN NAME OF

ELDON LOYD WILLIAMSON

Surveyed 2 June, 1959, by *R. Jackson*