
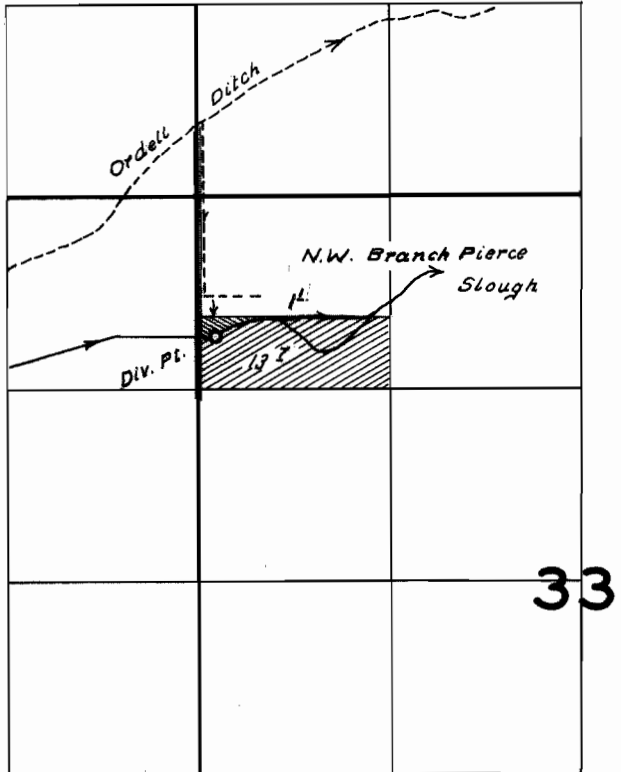


T. 2 S. R. 38 E. W.M.

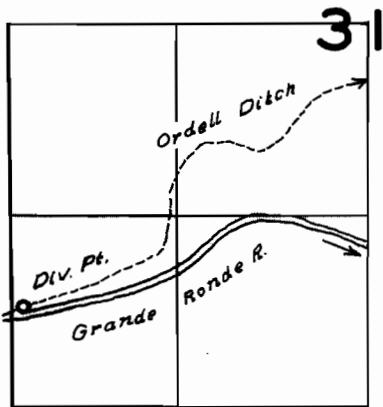

FINAL PROOF SURVEY
UNDER

Land Irrigated from Ordell Ditch
Land Irrigated from Pierce Slough

Application No. 25622... Permit No. 20100...
IN NAME OF



Roland W. Schaad

Surveyed Aug. 17/1959, by R.H. Jackson