


T. 12S. R. 1E. W.M.

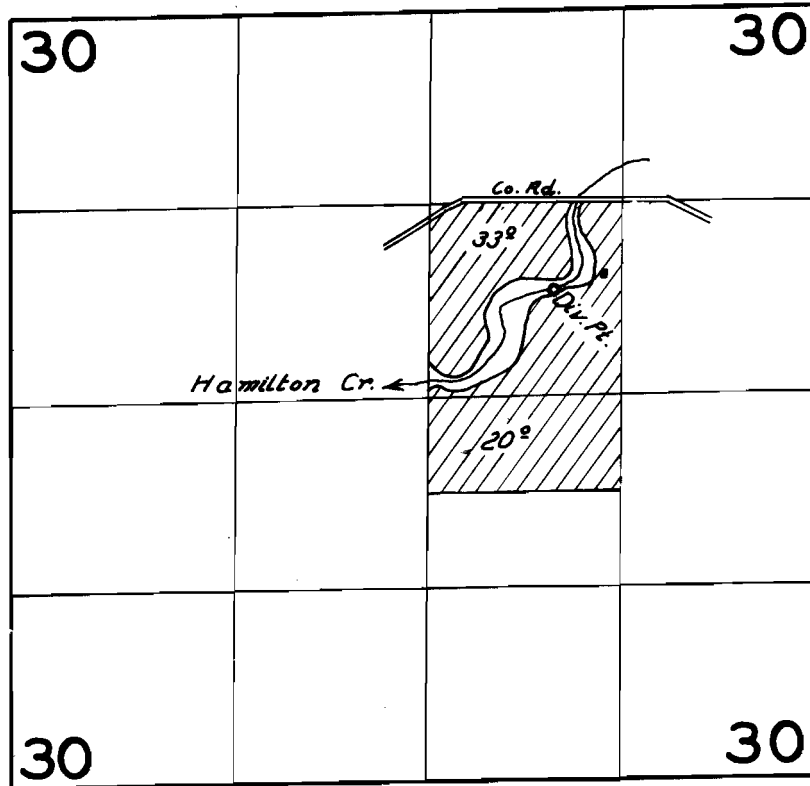

FINAL PROOF SURVEY

UNDER

App. No. 26334 and No. 20460

of  
Donald C. Piper

Surveyed Aug. 31, 1959, by R. H. Jackson