


# T. 1 S. R. 3 W. W. M.

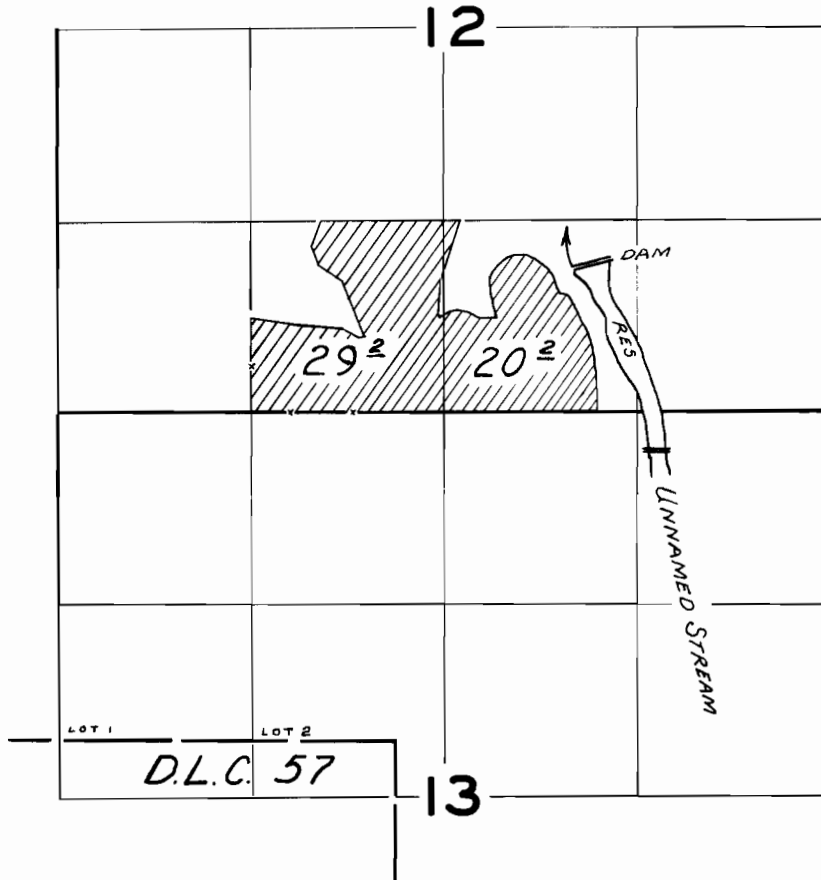

## FINAL PROOF SURVEY UNDER

Application No. R-26539 26540 Permit No. R-1269 20797

IN NAME OF

H. W. AND LAURA E. CURRIN

Surveyed MAY 27 1959, by R. JACKSON