


T. 1 S. R. 38 E. W.M.

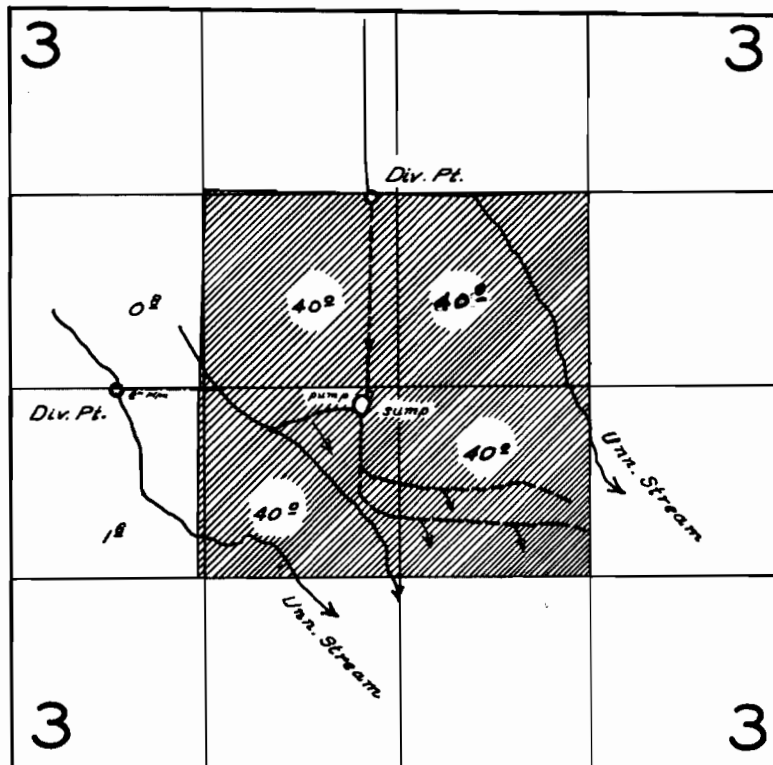

FINAL PROOF SURVEY
UNDER

Application No. 26665 Permit No. 21018
IN NAME OF

Norman Wyland

Surveyed Aug. 4, 1959, by R.H. Jackson.