


T. 2 N. R. 42 E. W.M.

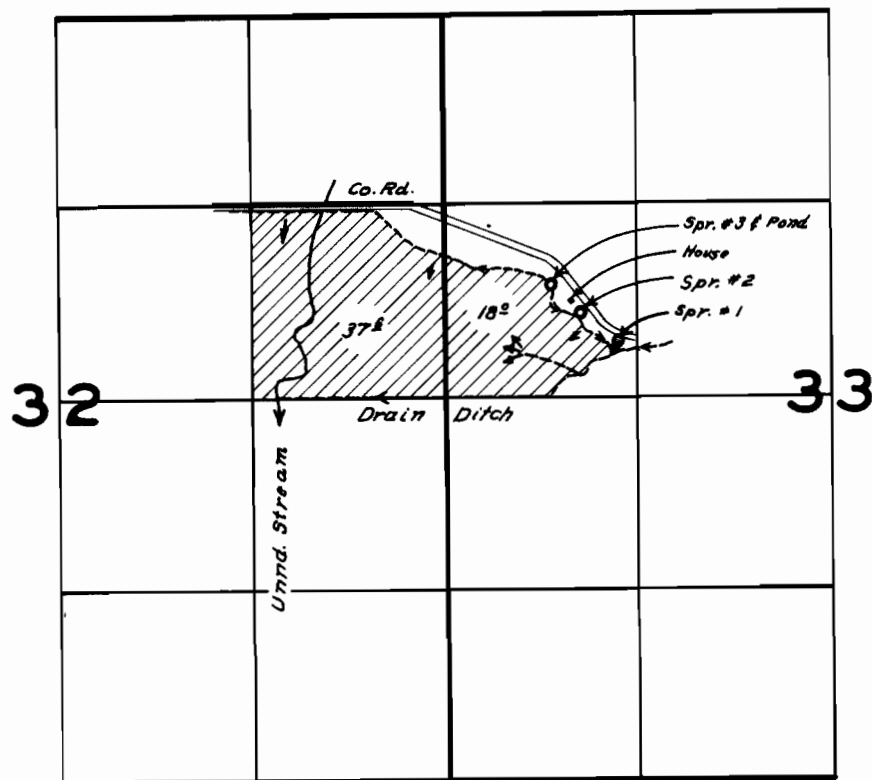

FINAL PROOF SURVEY
UNDER

Application No. 27237 Permit No. 21430
IN NAME OF

Flying A Quarter Circle Ranches, Inc.

Surveyed Aug. 12, 1959, by R. H. Jackson