


T. 11 S. R. 1 W. W.M.

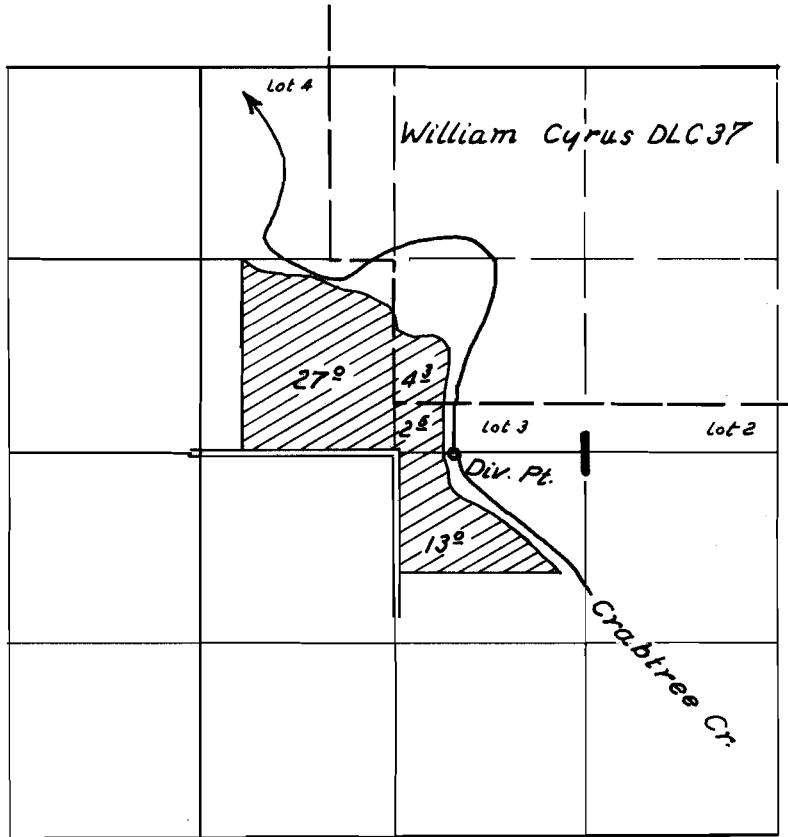

FINAL PROOF SURVEY

UNDER

Application No. 27834 Permit No. 21894

IN NAME OF

Lester M. & Belva Johnson

Surveyed Aug. 25 1959, by R. H. Jackson