


T. 7S. 1W. W.M.

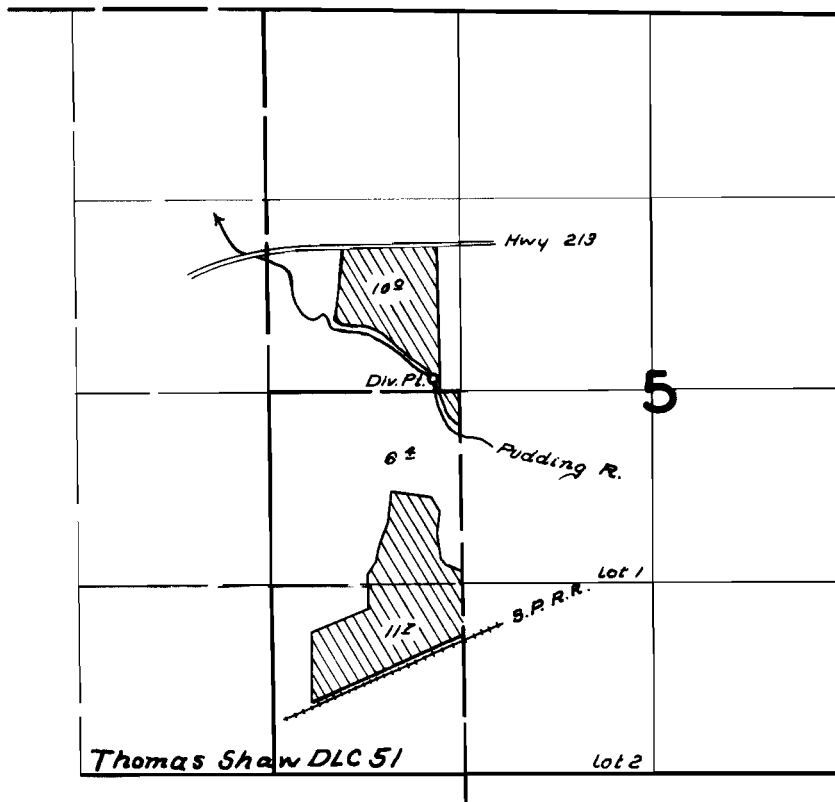

FINAL PROOF SURVEY UNDER

Application No. 26100..... Permit No. 21919.....
IN NAME OF

.....*Karl Dettwyler*.....

Surveyed *June 10* 1959, by *R. H. Jackson*.....