


T. 37S. R. 20E. W.M.

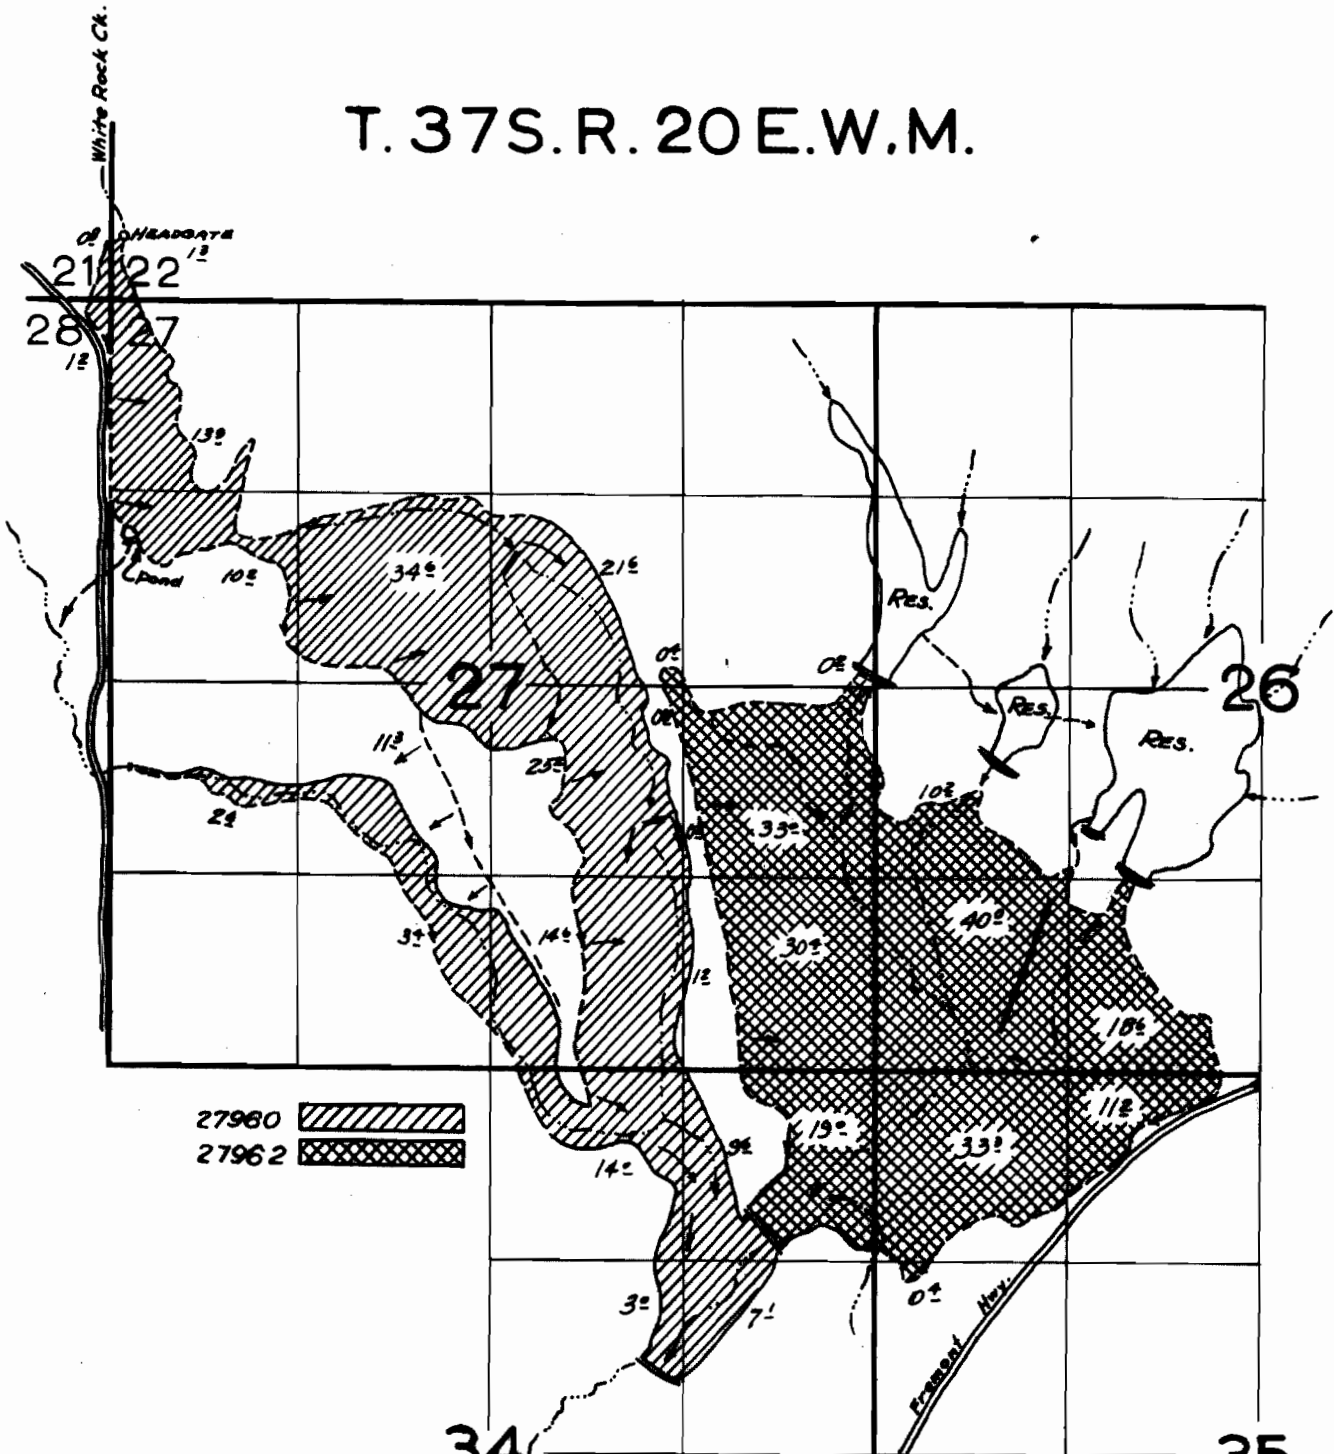

27960 [diagonal lines]
27962 [cross-hatch]

34 FINAL PROOF SURVEY 35
UNDER

27960 22110
R-27961 R-1481
Application No. 27962 Permit No. 22111
IN NAME OF

CON TAYLOR

Surveyed May 14, 1959, by R. Jackson