


T.23S.R.7 W.W.M.

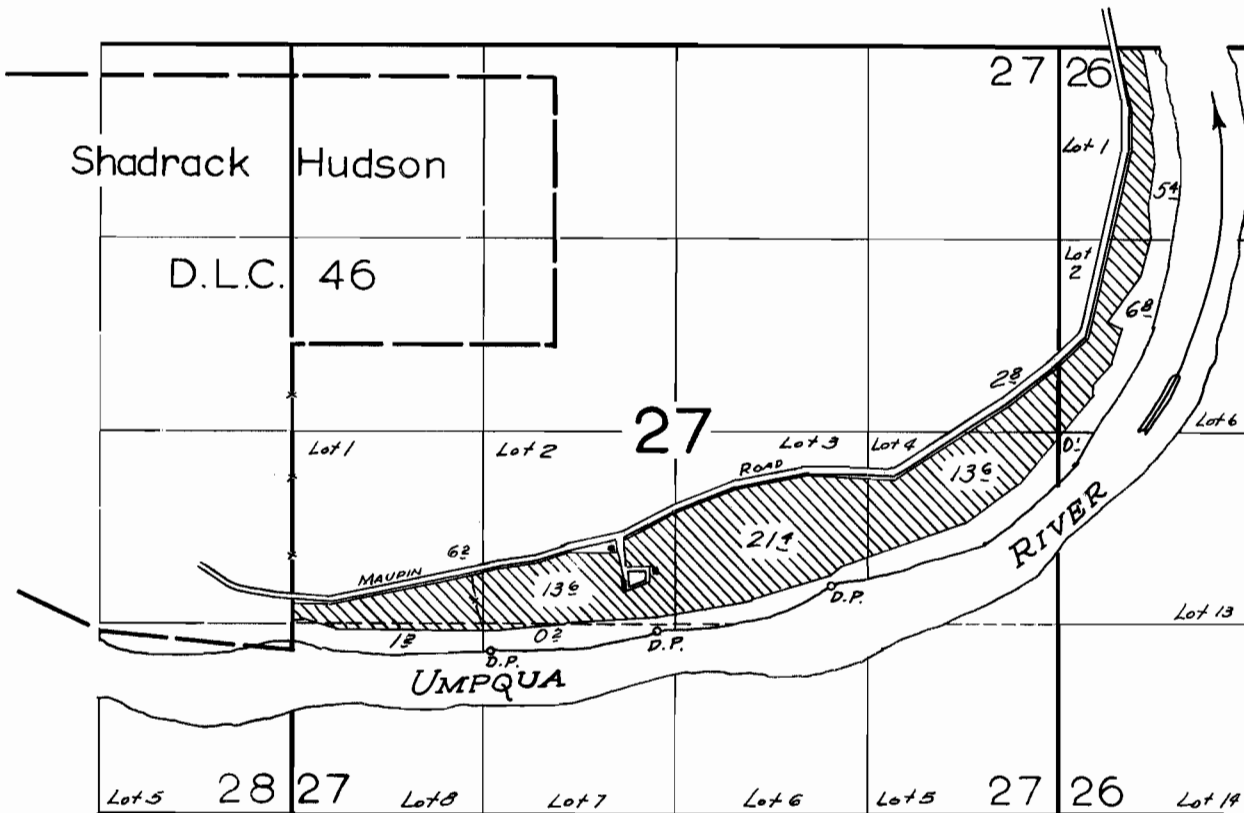

**FINAL PROOF SURVEY**  
UNDER

Application No. 28331. Permit No. 22364.  
IN NAME OF

V. K. HOLCOMB

Surveyed June 16-17 1959, by *R. H. Jackson*