


# T.2-3S.R.4W.W.M.

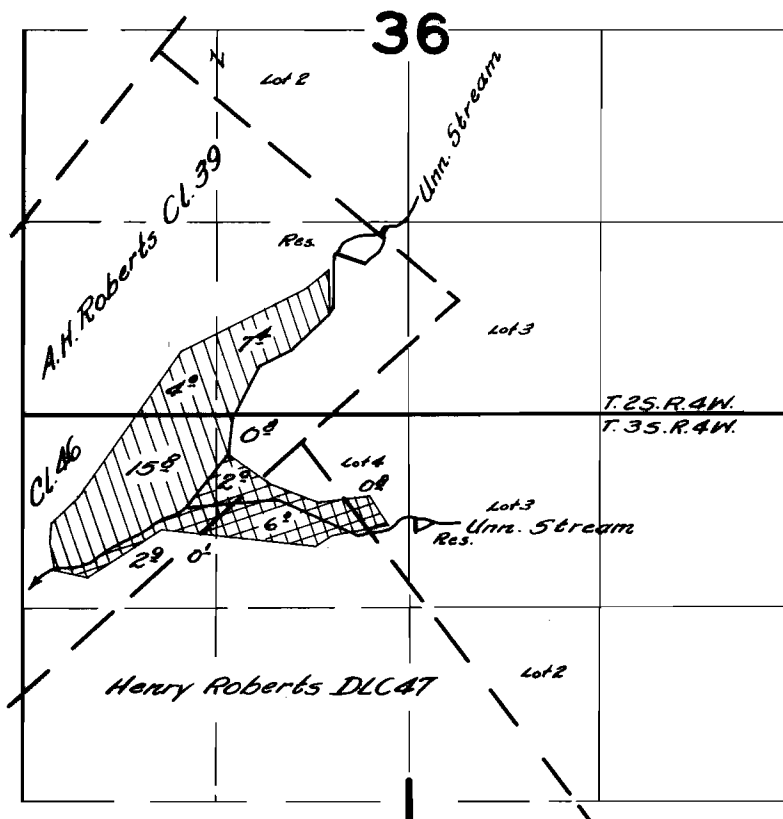

## FINAL PROOF SURVEY UNDER

Application No. ~~27784~~ <sup>R-27783</sup> Permit No. ~~22425~~ <sup>R-1517</sup>  
IN NAME OF

JOHN A. JOHNSON & SON

Surveyed March 16 1959, by C. D. Banteb