


T. 1N. R. 39E. W.M.

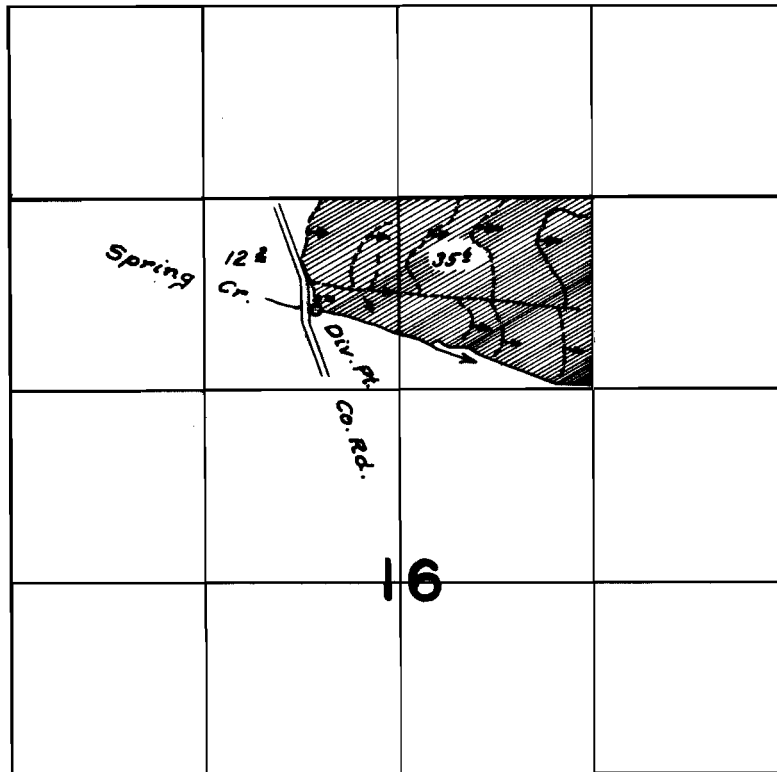

FINAL PROOF SURVEY UNDER

Application No. 28710 Permit No. 22604
IN NAME OF

William A. & Iola M. Botz

Surveyed Aug. 4, 1959, by R. H. Jackson