


T. 25 S. R. 7 W. W. M.

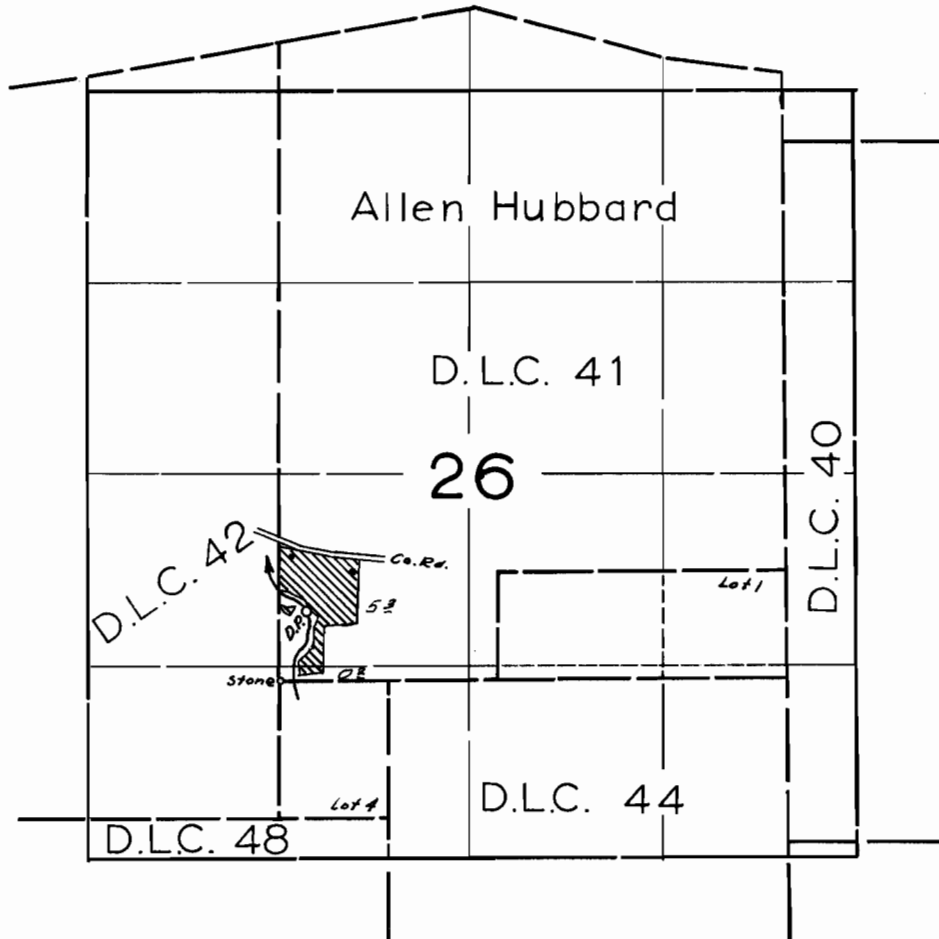

FINAL PROOF SURVEY
UNDER

Application No. 28401... Permit No. 22736
IN NAME OF

AMOS A. CASE

Surveyed June 25 1959, by *R. Jackson*