


T. 24 S. R. 5 W. W. M.

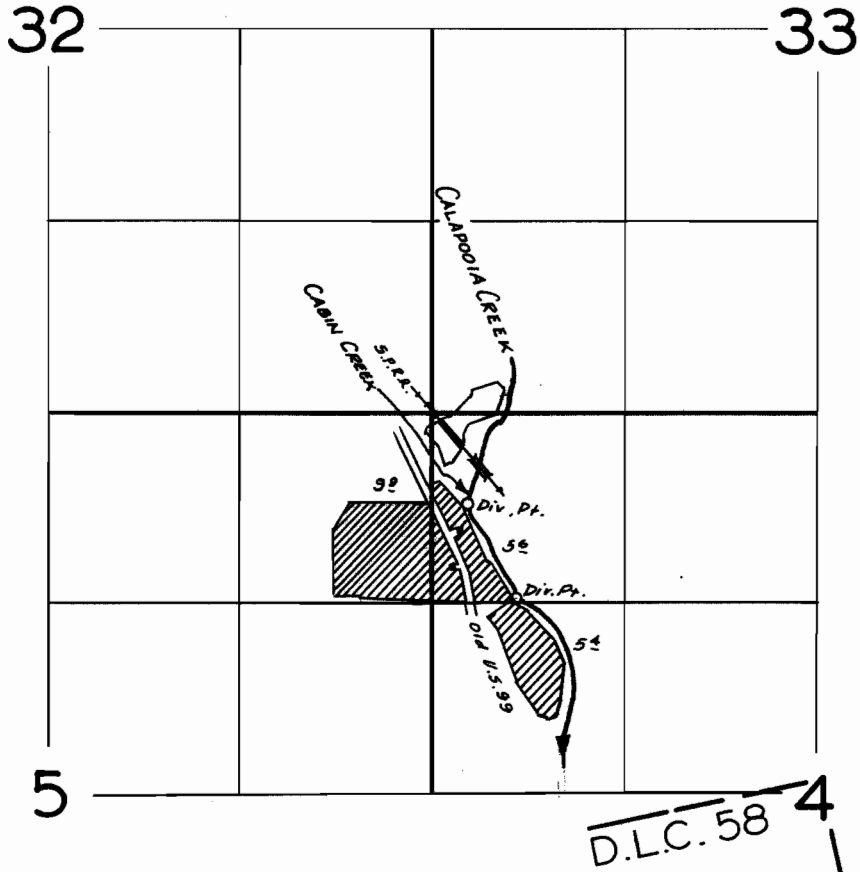

T. 25 S. R. 5 W. W. M.  
**FINAL PROOF SURVEY**  
UNDER

Application No. 29105. Permit No. 22878  
IN NAME OF

*ALBERT D. HILL*

Surveyed June 22 1959, by *R. Jackson*